


1 LOCATION OF WATER WELL:	Fraction	Section Number	Township Number	Range Number
County: Ottawa	NW 1/4 NW 1/4 SE 1/4	23	T 12 S	R 3 ●W

Distance and direction from nearest town or city street address of well if located within city?
3 miles South & 2 Miles West of Bennington, KS

2 WATER WELL OWNER: **Limbo Inc.**
 RR#, St. Address, Box # : **c/o Bennington State Bank** Board of Agriculture, Division of Water Resources
 City, State, ZIP Code : **200 S. 9th, Salina, KS 67401** Application Number:

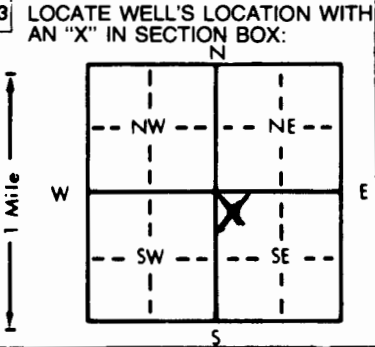

4 DEPTH OF COMPLETED WELL: **46** ft. ELEVATION: _____
 Depth(s) Groundwater Encountered 1. **13** ft. 2. _____ ft. 3. _____ ft.
 WELL'S STATIC WATER LEVEL **13** ft. below land surface measured on mo/day/yr **5-17-91**
 Pump test data: Well water was _____ ft. after _____ hours pumping _____ gpm
 Est. Yield **4-5** gpm: Well water was **37** ft. after **1** hours pumping **10** gpm
 Bore Hole Diameter **8** in. to **46** ft., and _____ in. to _____ ft.
 WELL WATER TO BE USED AS:
 5 Public water supply 8 Air conditioning 11 Injection well
 1 Domestic 3 Feedlot 6 Oil field water supply 9 Dewatering 12 Other (Specify below)
 2 Irrigation 4 Industrial 7 Lawn and garden only 10 Monitoring well _____ **Stock** _____
 Was a chemical/bacteriological sample submitted to Department? Yes _____ No **X** _____; If yes, mo/day/yr sample was submitted _____
 Water Well Disinfected? Yes **X** No

5 TYPE OF BLANK CASING USED:
 1 Steel 3 RMP (SR) 5 Wrought iron 8 Concrete tile CASING JOINTS: Glued **X** Clamped _____
 2 PVC 4 ABS 6 Asbestos-Cement 9 Other (specify below) Welded _____
 7 Fiberglass Threaded _____
 Blank casing diameter **5** in. to **30** ft., Dia **35** in. to **41** ft., Dia _____ in. to _____ ft.
 Casing height above land surface **12** in., weight **2.37** lbs./ft. Wall thickness or gauge No. **214**
 TYPE OF SCREEN OR PERFORATION MATERIAL:
 1 Steel 3 Stainless steel 5 Fiberglass 7 PVC 10 Asbestos-cement
 2 Brass 4 Galvanized steel 6 Concrete tile 8 RMP (SR) 11 Other (specify) _____
 9 ABS 12 None used (open hole)
 SCREEN OR PERFORATION OPENINGS ARE:
 1 Continuous slot 3 Mill slot 5 Gauzed wrapped 8 Saw cut 11 None (open hole)
 2 Louvered shutter 4 Key punched 6 Wire wrapped 9 Drilled holes
 7 Torch cut 10 Other (specify) _____
 SCREEN-PERFORATED INTERVALS: From **30** ft. to **35** ft., From _____ ft. to _____ ft.
 From **41** ft. to **46** ft., From _____ ft. to _____ ft.
 GRAVEL PACK INTERVALS: From **25** ft. to **46** ft., From _____ ft. to _____ ft.
 From _____ ft. to _____ ft., From _____ ft. to _____ ft.

6 GROUT MATERIAL: 1 Neat cement 2 Cement grout 3 Bentonite 4 Other _____
 Grout Intervals: From **5** ft. to **15** ft., From _____ ft. to _____ ft., From _____ ft. to _____ ft.
 What is the nearest source of possible contamination: **None within 1/2 mile** 10 Livestock pens 14 Abandoned water well
 1 Septic tank 4 Lateral lines 7 Pit privy 11 Fuel storage 15 Oil well/Gas well
 2 Sewer lines 5 Cess pool 8 Sewage lagoon 12 Fertilizer storage 16 Other (specify below)
 3 Watertight sewer lines 6 Seepage pit 9 Feedyard 13 Insecticide storage _____
 Direction from well? _____ How many feet? _____

FROM	TO	LITHOLOGIC LOG	FROM	TO	PLUGGING INTERVALS
0	3	Top Soil			
3	12	Brown Clay			
12	15	Creek Gravel			
15	18	Gray Shale			
18	35	Sandstone (Tan)			
35	46	Gray Shale			
46		Very Hard Iron pirite			

7 CONTRACTOR'S OR LANDOWNER'S CERTIFICATION: This water well was (1) constructed, (2) reconstructed, or (3) plugged under my jurisdiction and was completed on (mo/day/year) **5-17-91** and this record is true to the best of my knowledge and belief. Kansas Water Well Contractor's License No. **138** This Water Well Record was completed on (mo/day/yr) **5-21-91** under the business name of **Peterson Irrigation, Inc.** by (signature) *Mike Peterson*

OFFICE USE ONLY
T
R
EW
SEC.
1/4
1/4
1/4