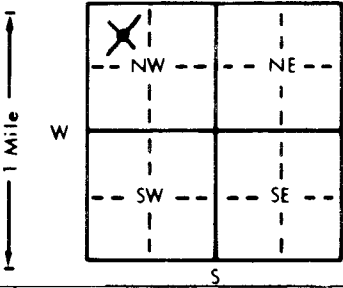


1 LOCATION OF WATER WELL: County: Ottawa Fraction: NW $\frac{1}{4}$ NW $\frac{1}{4}$ NW $\frac{1}{4}$ Section Number: 23 Township Number: T 12 S 1 Range Number: R 3 W

Distance and direction from nearest town or city street address of well if located within city?

2 miles West & 2 miles South of Bennington

2 WATER WELL OWNER: Gale Gwennap
 RR#, St. Address, Box #: 902 Cherokee Dr. Board of Agriculture, Division of Water Resources
 City, State, ZIP Code: Salina, KS 67401 Application Number:

3 LOCATE WELL'S LOCATION WITH AN "X" IN SECTION BOX:  4 DEPTH OF COMPLETED WELL: 98 ft. ELEVATION: ~1350?
 Depth(s) Groundwater Encountered: 1 51 ft. 2. ft. 3. ft.
 WELL'S STATIC WATER LEVEL: 51 ft. below land surface measured on mo/day/yr 4-16-90
 Pump test data: Well water was ft. after hours pumping gpm
 Est. Yield: 4-8 gpm: Well water was 90 ft. after 1 hours pumping 6 gpm
 Bore Hole Diameter: 8 in. to 105 ft. and in. to ft.
 WELL WATER TO BE USED AS: 5 Public water supply 8 Air conditioning 11 Injection well
1 Domestic 3 Feedlot 6 Oil field water supply 9 Dewatering 12 Other (Specify below)
2 Irrigation 4 Industrial 7 Lawn and garden only 10 Monitoring well
 Was a chemical/bacteriological sample submitted to Department? Yes No X ; If yes, mo/day/yr sample was submitted
 Water Well Disinfected? Yes X No

5 TYPE OF BLANK CASING USED: 5 Wrought iron 8 Concrete tile CASING JOINTS: Glued X Clamped
 1 Steel 3 RMP (SR) 6 Asbestos-Cement 9 Other (specify below) Welded
2 PVC 4 ABS 7 Fiberglass Threaded
 Blank casing diameter: 5 in. to 62 ft., Dia 70 in. to 90 ft., Dia in. to ft.
 Casing height above land surface: 12 in., weight 2.37 lbs./ft. Wall thickness or gauge No. .214
 TYPE OF SCREEN OR PERFORATION MATERIAL: 7 PVC 10 Asbestos-cement
 1 Steel 3 Stainless steel 5 Fiberglass 8 RMP (SR) 11 Other (specify)
 2 Brass 4 Galvanized steel 6 Concrete tile 9 ABS 12 None used (open hole)
 SCREEN OR PERFORATION OPENINGS ARE: 5 Gauzed wrapped 8 Saw cut 11 None (open hole)
 1 Continuous slot 3 Mill slot 6 Wire wrapped 9 Drilled holes
 2 Louvered shutter 4 Key punched 7 Torch cut 10 Other (specify)
 SCREEN-PERFORATED INTERVALS: From 60 ft. to 70 ft., From ft. to ft.
 From 90 ft. to 98 ft., From ft. to ft.
 GRAVEL PACK INTERVALS: From 25 ft. to 98 ft., From ft. to ft.
 From ft. to ft., From ft. to ft.

6 GROUT MATERIAL: 1 Neat cement 2 Cement grout 3 Bentonite 4 Other
 Grout Intervals: From 0 ft. to 25 ft., From ft. to ft., From ft. to ft.
 What is the nearest source of possible contamination: None within 1/4 mile 10 Livestock pens 14 Abandoned water well
 1 Septic tank 4 Lateral lines 7 Pit privy 11 Fuel storage 15 Oil well/Gas well
 2 Sewer lines 5 Cess pool 8 Sewage lagoon 12 Fertilizer storage 16 Other (specify below)
 3 Watertight sewer lines 6 Seepage pit 9 Feedyard 13 Insecticide storage

Direction from well? How many feet?

FROM	TO	LITHOLOGIC LOG	FROM	TO	PLUGGING INTERVALS
0	4	Top Soil			
4	9	Tan Clay			
9	10	Sandrock			
10	18	Gray Shale			
18	29	Sandstone with small shale layers			
29	39	Gray Shale			
39	44	Sandstone			
44	52	Gray shale with sandstone layers			
52	71	Gray Shale			
71	103	Gray shale with very hard & small sandstone layers			
103	105	Gray shale			

7 CONTRACTOR'S OR LANDOWNER'S CERTIFICATION: This water well was (1) constructed, (2) reconstructed, or (3) plugged under my jurisdiction and was completed on (mo/day/year) 4-16-90 and this record is true to the best of my knowledge and belief. Kansas Water Well Contractor's License No. 138 This Water Well Record was completed on (mo/day/yr) 4-29-90 under the business name of Peterson Irrigation, Inc. by (signature) M. Peterson