


USE TYPEWRITER OR BALL POINT PEN—PRESS FIRMLY, PRINT CLEARLY.

WATER WELL RECORD
KSA 82a-1201-1215

Kansas Department of Health and Environment—Division of Environment (Water well Contractors)
Topeka, Kansas 66620

1. Location of well:		County <i>Ottawa</i>	Fraction <i>SE 1/4 NW 1/4 NE 1/4</i>	Section number <i>30</i>	Township number <i>T 12</i>	Range number <i>S R 3 E 10</i>
2. Distance and direction from nearest town or city: Street address of well location if in city:				3. Owner of well: <i>Robt. Sindon</i> R.R. or street: <i>864 Pearl</i> City, state, zip code: <i>Salina Kans. 67401</i>		
4. Locate with "X" in section below: N W E S 1 Mile			Sketch map: <i>Open pasture</i> <i>Open pasture X well Open pasture</i> <i>Open pasture</i>		6. Bore hole dia. <i>6</i> in. Completion date <i>3-15-76</i> Well depth <i>148</i> ft.	
5. Type and color of material			From	To	7. <input checked="" type="checkbox"/> Cable tool <input checked="" type="checkbox"/> Rotary <input type="checkbox"/> Driven <input type="checkbox"/> Dug <input type="checkbox"/> Hollow rod <input type="checkbox"/> Jetted <input type="checkbox"/> Bored <input type="checkbox"/> Reverse rotary	
Colluvium: <i>Sand, silty, light brown</i>			<i>0</i>	<i>14</i>	8. Use: <input checked="" type="checkbox"/> Domestic <input type="checkbox"/> Public supply <input type="checkbox"/> Industry <input type="checkbox"/> Irrigation <input type="checkbox"/> Air conditioning <input type="checkbox"/> Stock <input type="checkbox"/> Lawn <input type="checkbox"/> Oil field water <input type="checkbox"/> Other	
<i>Dolomite (?) & Kiowa:</i>					9. Casing: Material <i>PVC</i> Height: <input checked="" type="checkbox"/> Above or below Threaded <input type="checkbox"/> Welded <input type="checkbox"/> Surface <i>12</i> in. RMP <input type="checkbox"/> PVC <input type="checkbox"/> Weight <input type="checkbox"/> lbs./ft. Dia. <i>4</i> in. to <i>148</i> ft. depth Wall Thickness: inches or Dia. <input type="checkbox"/> in. to <input type="checkbox"/> ft. depth gage No. <i>E237</i>	
<i>Shale, clayey, mottled red yellow</i>			<i>14</i>	<i>25</i>	10. Screen: Manufacturer's name <i>SAP</i> Type <i>slots</i> Dia. <i>4"</i> Slot/gauze <i>1/16</i> Length <i>10"</i> Set between <i>138</i> ft. and <i>148</i> ft. ft. and <input type="checkbox"/> ft. Gravel pack? <input checked="" type="checkbox"/> Size range of material <i>2 mm</i>	
<i>Sandstone, fine to medium, yellow & brown</i>			<i>25</i>	<i>32</i>	11. Static water level: <input type="checkbox"/> mo./day/yr. <i>67</i> ft. below land surface Date <i>3-15-76</i>	
<i>Shale, gray</i>			<i>32</i>	<i>55</i>	12. Pumping level below land surfaces: <input type="checkbox"/> ft. after <i>1.5</i> hrs. pumping <i>10</i> g.p.m. <input type="checkbox"/> ft. after <input type="checkbox"/> hrs. pumping <input type="checkbox"/> g.p.m. Estimated maximum yield <i>10</i> g.p.m.	
<i>Shale, gray; contains thin beds of</i>					13. Water sample submitted: <input type="checkbox"/> Yes <input checked="" type="checkbox"/> No Date	
<i>sandstone, very fine, silty</i>			<i>55</i>	<i>103</i>	14. Well head completion: <input type="checkbox"/> Pitless adapter <i>12</i> inches above grade	
<i>Sandstone, fine-very fine, soft, light gray</i>			<i>103</i>	<i>113.5</i>	15. Well grouted? <input checked="" type="checkbox"/> Y With: <input checked="" type="checkbox"/> Neat cement <input type="checkbox"/> Bentonite <input type="checkbox"/> Concrete Depth: From <i>3</i> ft. to <i>13</i> ft.	
<i>Shale, gray contains hard siderite nodules</i>			<i>113.5</i>	<i>115</i>	16. Nearest source of possible contamination: ft. _____ Direction _____ Type _____ Well disinfected upon completion? <input checked="" type="checkbox"/> X Yes <input type="checkbox"/> No	
<i>Sandstone, very fine, light gray, silty, soft</i>			<i>115</i>	<i>148</i>	17. Pump: <input checked="" type="checkbox"/> Not installed Manufacturer's name _____ Model number _____ HP _____ Volts _____ Length of drop pipe _____ ft. capacity _____ g.p.m. Type: <input type="checkbox"/> Submersible <input type="checkbox"/> Turbine <input type="checkbox"/> Jet <input type="checkbox"/> Reciprocating <input type="checkbox"/> Centrifugal <input type="checkbox"/> Other	
(Use a second sheet if needed)						
18. Elevation:		19. Remarks:				
Topography: <input type="checkbox"/> Hill <input checked="" type="checkbox"/> Slope <input type="checkbox"/> Upland <input type="checkbox"/> Valley						
		20. Water well contractor's certification: This well was drilled under my jurisdiction and this report is true to the best of my knowledge and belief. Business name <i>Salina Drilling Co.</i> License No. <i>126</i> Address <i>Salina, Kans.</i> Signed <i>[Signature]</i> Date <i>5-17-76</i> Authorized representative				

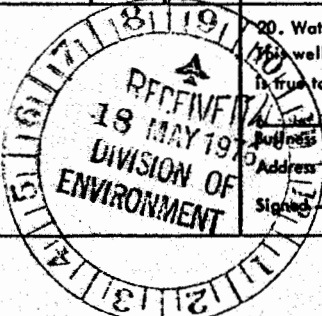

T-12-310-1154-116-118-119-120

Forward the white, blue and pink copies to the Department of Health and Environment

Form WWC-5