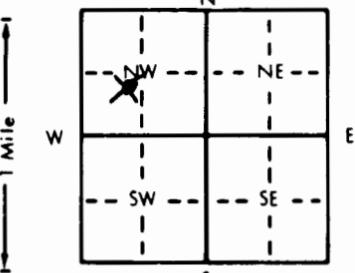


1 LOCATION OF WATER WELL:		Fraction	Section Number	Township Number	Range Number
County: Ottawa		near 1/4 center 1/4 NW 1/4	35	T 12 S	R 3 E/W
Distance and direction from nearest town or city street address of well if located within city? 2 miles West & 4 miles South of Bennington, KS					
2 WATER WELL OWNER:		Doug Michaelis			
RR#, St. Address, Box # :		1626 Aspen Road			
City, State, ZIP Code :		Bennington, KS 67422			
Board of Agriculture, Division of Water Resources		Application Number: N/A			
3 LOCATE WELL'S LOCATION WITH AN "X" IN SECTION BOX:		4 DEPTH OF COMPLETED WELL: 120 ft. ELEVATION:			
		Depth(s) Groundwater Encountered 1. ft. 2. ft. 3. ft. WELL'S STATIC WATER LEVEL 30 ft. below land surface measured on mo/day/yr 2/6/98 Pump test data: Well water was ft. after hours pumping gpm Est. Yield 10-15 gpm: Well water was ft. after hours pumping gpm Bore Hole Diameter .8 in. to 1.21 ft., and in. to ft. WELL WATER TO BE USED AS: 5 Public water supply 8 Air conditioning 11 Injection well X Domestic 3 Feedlot 6 Oil field water supply 9 Dewatering 12 Other (Specify below) 2 Irrigation 4 Industrial 7 Lawn and garden only 10 Monitoring well Was a chemical/bacteriological sample submitted to Department? Yes No X If yes, mo/day/yr sample was submitted Water Well Disinfected? Yes X No			
5 TYPE OF BLANK CASING USED:		CASING JOINTS: Glued X Clamped			
1 Steel 3 RMP (SR) X PVC 4 ABS		5 Wrought iron 8 Concrete tile 6 Asbestos-Cement 9 Other (specify below) Welded 7 Fiberglass Threaded			
Blank casing diameter 5 in. to 100 ft., Dia in. to ft., Dia in. to ft.		Casing height above land surface 12 in., weight 2.37 lbs./ft. Wall thickness or gauge No. .214			
TYPE OF SCREEN OR PERFORATION MATERIAL:		X PVC 10 Asbestos-cement			
1 Steel 3 Stainless steel 5 Fiberglass 8 RMP (SR) 11 Other (specify)		2 Brass 4 Galvanized steel 6 Concrete tile 9 ABS 12 None used (open hole)			
SCREEN OR PERFORATION OPENINGS ARE:		5 Gauzed wrapped 8 Saw cut 11 None (open hole)			
1 Continuous slot X Mill slot 6 Wire wrapped 9 Drilled holes		2 Louvered shutter 4 Key punched 7 Torch cut 10 Other (specify)			
SCREEN-PERFORATED INTERVALS: From 100 ft. to 120 ft., From ft. to ft.		From ft. to ft., From ft. to ft.			
GRAVEL PACK INTERVALS: From 20 ft. to 120 ft., From ft. to ft.		From ft. to ft., From ft. to ft.			
6 GROUT MATERIAL:		4 Other			
1 Neat cement 2 Cement grout X Bentonite		Grout Intervals: From 0 ft. to 20 ft., From ft. to ft., From ft. to ft.			
What is the nearest source of possible contamination: None within 1/4 mile		10 Livestock pens 14 Abandoned water well			
1 Septic tank 4 Lateral lines 7 Pit privy 11 Fuel storage 15 Oil well/Gas well		2 Sewer lines 5 Cess pool 8 Sewage lagoon 12 Fertilizer storage 16 Other (specify below)			
3 Watertight sewer lines 6 Seepage pit 9 Feedyard 13 Insecticide storage		Direction from well? How many feet?			
FROM TO LITHOLOGIC LOG FROM TO PLUGGING INTERVALS					
0 2 Top Soil					
2 14 Tan Clay					
14 31 Gray Shale					
31 42 Red Shale					
42 60 Gray Shale					
60 74 Red Shale					
74 120 Sandstone					
120 121 Gray Shale					
7 CONTRACTOR'S OR LANDOWNER'S CERTIFICATION: This water well was M constructed, (2) reconstructed, or (3) plugged under my jurisdiction and was completed on (mo/day/year) 2/6/98 and this record is true to the best of my knowledge and belief. Kansas Water Well Contractor's License No. 138 This Water Well Record was completed on (mo/day/yr) 2/19/98 under the business name of Peterson Irrigation, Inc. by (signature) <i>Michael Peterson</i>					
INSTRUCTIONS: Use typewriter or ball point pen. PLEASE PRESS FIRMLY and PRINT clearly. Please fill in blanks, underline or circle the correct answers. Send top three copies to Kansas Department of Health and Environment, Bureau of Water, Topeka, Kansas 66620-0001. Telephone: 913-296-5545. Send one to WATER WELL OWNER and retain one for your records.					