USE TYPEWRITER OR BALL POINT PEN-PRESS FIRMLY, PRINT CLEARLY.

WATER WELL RECORD
KSA 82a-1201-1215

BBB

Kansas Department of Health and Environment-Division of Environment
(Water well Contractors)
Topeka, Kansas 66620

1. Location of well:	County	Fraction	Section number	Township number	Range number
	Gove	NW 1/4 NW 1/4 NW 1/4	26	T 12 S	R 30 E/W

2. Distance and direction from nearest town or city: GRINNELL Ks.
Street address of well location if in city: 10 Mi So.

3. Owner of well: DENNIS DOHM
R.R. or street:
City, state, zip code: GRINNELL 67738

4. Locate with "X" in section below:

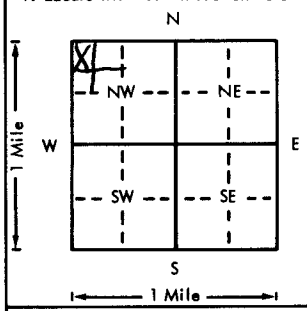

Sketch map:

6. Bore hole dia. 9 in. Completion date 9-24-77
Well depth 73 ft.

7. __ Cable tool X Rotary __ Driven __ Dug
__ Hollow rod __ Jetted __ Bored __ Reverse rotary

8. Use: X Domestic __ Public supply __ Industry
__ Irrigation __ Air conditioning __ Stock
__ Lawn __ Oil field water __ Other

9. Casing: Material _____ Height: Above or below
Threaded ____ Welded ____ Surface 4' Below in.
RMP ____ PVC X Weight _____ lbs./ft.
Dia. 5 in. to 73 ft. depth Wall Thickness: inches or
Dia. ____ in. to ____ ft. depth gage No. 200

5. Type and color of material	From	To
Top soil	0	18
sandy clay	18	34
M. Gravel	34	64
sandy clay	64	69
Gravel	69	72
Ochre	72	73
BROCK 72'		
(Use a second sheet if needed)		

10. Screen: Manufacturer's name
Jess Lowell
Type PVC Dia. 5
Slot/gauze 18 Length 8'
Set between 65 ft. and 73 ft.
____ ft. and ____ ft.
Gravel pack? X Size range of material 1/8 x 1/4

11. Static water level: mo./day/yr.
48 ft. below land surface Date 9-24-77

12. Pumping level below land surfaces:
____ ft. after ____ hrs. pumping ____ g.p.m.
____ ft. after ____ hrs. pumping ____ g.p.m.
Estimated maximum yield 30 plus g.p.m.

13. Water sample submitted: mo./day/yr.
__ Yes X No Date

14. Well head completion:
✓ Pitless adapter 12" Inches above grade

15. Well grouted? X
With: ____ Neat cement X Bentonite ____ Concrete
Depth: From 14 ft. to 4 ft.

16. Nearest source of possible contamination: none
ft. ____ Direction ____ Type ____
Well disinfected upon completion? ✓ Yes ____ No

17. Pump: ____ Not installed
Manufacturer's name Goulds
Model number 25EL HP 1 Volts 230
Length of drop pipe 68 ft. capacity 18 g.p.m.
Type:
✓ Submersible ____ Turbine
____ Jet ____ Reciprocating
____ Centrifugal ____ Other

18. Elevation:

Topography:
____ Hill
____ Slope
X Upland
____ Valley

19. Remarks:

20. Water well contractor's certification:
This well was drilled under my jurisdiction and this report is true to the best of my knowledge and belief.
STRUCKHOFF SONS 298
Business name License No.
Address GRINNELL Ks
Signed K Struckhoff Date 10-15-77
Authorized representative

T 12 R 30 E/W Sec 26 1/4 NW 1/4 NW 1/4 NW

Forward the white, blue and pink copies to the Department of Health and Environment

Form WWC-5

MI-1023