


1 LOCATION OF WATER WELL: County: **GOVE** Fraction: **NW 1/4 SW 1/4 NW 1/4** Section Number: **27** Township Number: **T 12 S** Range Number: **R 31 E/W**

Distance and direction from nearest town or city street address of well if located within city?

**14 W; 4 S of GOVE, KANSAS**

2 WATER WELL OWNER: **GLENNIS PARSONS**  
 RR#, St. Address, Box #: **804 E. 5th** Board of Agriculture, Division of Water Resources  
 City, State, ZIP Code: **OAKLEY, KS 67748** Application Number:

3 LOCATE WELL'S LOCATION WITH AN "X" IN SECTION BOX:

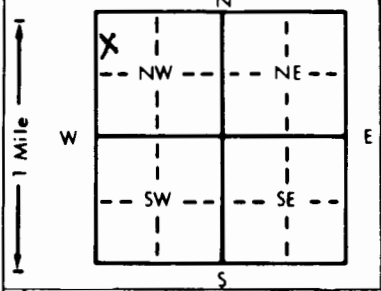

4 DEPTH OF COMPLETED WELL: **60** ft. ELEVATION:

Depth(s) Groundwater Encountered 1. **45** ft. 2. ft. 3. ft.  
 WELL'S STATIC WATER LEVEL **45** ft. below land surface measured on mo/day/yr  
 Pump test data: Well water was ft. after hours pumping gpm  
 Est. Yield **15** gpm; Well water was ft. after hours pumping gpm  
 Bore Hole Diameter: **8 3/4** in. to **60** ft., and in. to ft.  
 WELL WATER TO BE USED AS:  
 1 Domestic 3 Feedlot 6 Oil field water supply 9 Dewatering 12 Other (Specify below)  
 2 Irrigation 4 Industrial 7 Lawn and garden only 10 Monitoring well  
 Was a chemical/bacteriological sample submitted to Department? Yes No; If yes, mo/day/yr sample was submitted  
 Water Well Disinfected? Yes **X** No

5 TYPE OF BLANK CASING USED:  
 1 Steel 3 RMP (SR) 5 Wrought iron 8 Concrete tile CASING JOINTS: Glued **X** Clamped  
 2 PVC 4 ABS 6 Asbestos-Cement 9 Other (specify below) Welded  
 7 Fiberglass Threaded

Blank casing diameter **5** in. to **50** ft., Dia in. to ft., Dia in. to ft.  
 Casing height above land surface **10** in., weight **160** lbs./ft. Wall thickness or gauge No.

TYPE OF SCREEN OR PERFORATION MATERIAL:  
 1 Steel 3 Stainless steel 5 Fiberglass 8 RMP (SR) 10 Asbestos-cement  
 2 Brass 4 Galvanized steel 6 Concrete tile 9 ABS 11 Other (specify)  
 12 None used (open hole)

SCREEN OR PERFORATION OPENINGS ARE:  
 1 Continuous slot 3 Mill slot 5 Gauzed wrapped 8 Saw cut 11 None (open hole)  
 2 Louvered shutter 4 Key punched 6 Wire wrapped 9 Drilled holes  
 7 Torch cut 10 Other (specify)

SCREEN-PERFORATED INTERVALS: From **50** ft. to **60** ft., From ft. to ft.  
 GRAVEL PACK INTERVALS: From **40** ft. to **60** ft., From ft. to ft.

6 GROUT MATERIAL: 1 Neat cement 2 Cement grout 3 Bentonite 4 Other  
 Grout Intervals: From **0** ft. to **20** ft., From ft. to ft., From ft. to ft.

What is the nearest source of possible contamination:  
 1 Septic tank 4 Lateral lines 7 Pit privy 10 Livestock pens 14 Abandoned water well  
 2 Sewer lines 5 Cess pool 8 Sewage lagoon 11 Fuel storage 15 Oil well/Gas well  
 3 Watertight sewer lines 6 Seepage pit 9 Feedyard 12 Fertilizer storage 16 Other (specify below)  
 13 Insecticide storage 16 **NONE**

Direction from well? **N/A** How many feet? **N/A**

FROM	TO	LITHOLOGIC LOG	FROM	TO	PLUGGING INTERVALS
0	5	TOP SOIL			
5	15	BROWN CLAY			
15	25	FINE SAND			
25	35	BROWN CLAY			
35	45	FINE SAND			
45	58	MEDIUM SAND			
58	59	YELLOW CLAY			
59	60	BLUE SHALE			

7 CONTRACTOR'S OR LANDOWNER'S CERTIFICATION: This water well was (1) constructed, (2) reconstructed, or (3) plugged under my jurisdiction and was completed on (mo/day/year) **05/12/05** and this record is true to the best of my knowledge and belief. Kansas Water Well Contractor's License No. **489** This Water Well Record was completed on (mo/day/yr) **06/06/05** under the business name of **AQUA PUMP** by (signature) *[Signature]*

OFFICE USE ONLY T R E/W SEC. 1/4 1/4 1/4