USE TYPEWRITER OR BALL POINT PEN-PRESS FIRMLY, PRINT CLEARLY.

WATER WELL RECORD
KSA 82a-1201-1215

BBB Oakley South

Kansas Department of Health and Environment-Division of Environment
(Water well Contractors)
Topeka, Kansas 66620

1. Location of well:	County	Fraction	Section number	Township number	Range number
	LOGAN	NW/4 NW/4 NW/4	2	T 12 S	R 32 E/W

2. Distance and direction from nearest town or city: 5 mi SO OF OAKLEY
Street address of well location if in city:

3. Owner of well: RICHARD MATHER
R.R. or street: Rt 2
City, state, zip code: OAKLEY KS

4. Locate with "X" in section below:

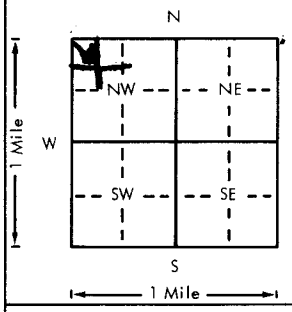

Sketch map:

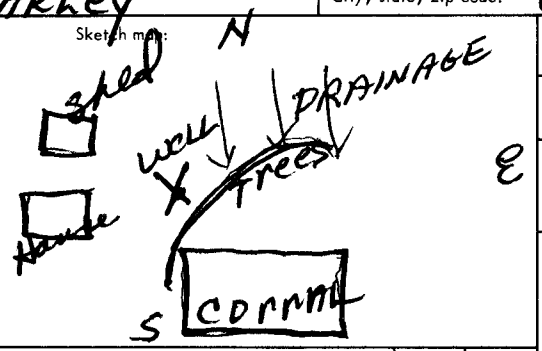

6. Bore hole dia. 8 in. Completion date 12-23-78
Well depth 100 ft.

7. __ Cable tool ✓ Rotary __ Driven __ Dug
__ Hollow rod __ Jetted __ Bored __ Reverse rotary

8. Use: __ Domestic __ Public supply __ Industry
__ Irrigation __ Air conditioning ✓ Stock
__ Lawn __ Oil field water __ Other

9. Casing: Material ____ Height (Above) or below
Threaded ____ Welded GL Surface 12 in.
RMP ____ PVC ✓ Weight ____ lbs./ft.
Dia. 5 in. to 80 ft. depth Wall Thickness: inches or
Dia. ____ in. to ____ ft. depth gage No. .250

5. Type and color of material	From	To
TOP SOIL	0	7
CLAY	7	23
FINE TO MED SAND	23	35
LIMESTONE	35	38
SANDY CLAY	38	52
MED. SAND	52	65
BROWN CLAY	65	70
MED. SAND	70	88
YELLOW CLAY	88	98
BLUE SHALE	98	100
BROCK 88'		

(Use a second sheet if needed)

10. Screen: Manufacturer's name JESS & LOWELL
Type PVC Dia. 5
Slot gauze 1/16 Length 20
Set between 80 ft. and 100 ft.
____ ft. and ____ ft.
Gravel pack? yes Size range of material 1/8-1/4

11. Static water level: mo./day/yr.
54 ft. below land surface Date 12-23-79

12. Pumping level below land surfaces: BAILED
____ ft. after AT 10 GPM hrs. pumping ____ g.p.m.
____ ft. after ____ hrs. pumping ____ g.p.m.
Estimated maximum yield 30 g.p.m.

13. Water sample submitted: mo./day/yr.
__ Yes ✓ No Date

14. Well head completion: CASING
__ Pitless adapter 12 Inches above grade

15. Well grouted? yes
With: __ Neat cement ✓ Bentonite __ Concrete
Depth: From 6 ft. to 10 ft.

16. Nearest source of possible contamination:
ft. 75 Direction SO Type CORRAL
Well disinfected upon completion? __ Yes ✓ No

17. Pump: ✓ Not installed
Manufacturer's name
Model number HP Volts
Length of drop pipe ____ ft. capacity ____ g.p.m.
Type:
__ Submersible __ Turbine
__ Jet __ Reciprocating
__ Centrifugal __ Other

T 12 R 32 W Sec 2 1/4 NW 1/4 NW 1/4 NW 1/4

18. Elevation: 3000 Topo Tm
Topography:
X Hill
__ Slope
__ Upland
__ Valley

19. Remarks: FARMER TO INSTALL PUMP.

20. Water well contractor's certification: #385
This well was drilled under my jurisdiction and this report is true to the best of my knowledge and belief.
Business name SCOTT DRILLING License No.
Address OAKLEY KS
Signed Richard L. Scott Date 8-1-79
Authorized representative

Forward the white, blue and pink copies to the Department of Health and Environment

Form WWC-5

MI-1023