


1 LOCATION OF WATER WELL:	Fraction	Section Number	Township Number	Range Number
County: <b>Logan</b>	<b>SE 1/4 NW 1/4 NE 1/4</b>	<b>4</b>	<b>12</b>	<b>34W</b>

Distance and direction from nearest town or city street address of well if located within city?

2 WATER WELL OWNER: **Larry Kuhlman**  
 RR#, St. Address, Box # **1912 US 83**  
 City, State, ZIP Code : **Oakley, KS 67748**

Board of Agriculture, Division of Water Resources  
 Application Number:

3 MARK WELL'S LOCATION WITH AN "X" IN SECTION BOX:

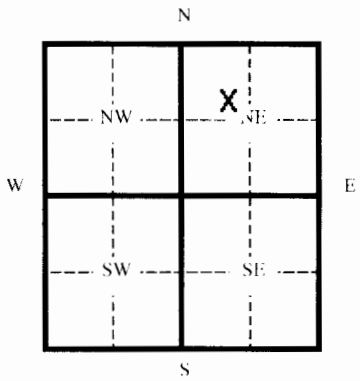

4 DEPTH OF WELL **215** ft.

WELL'S STATIC WATER LEVEL **129** ft.

- WELL WAS USED AS:
- |              |   |                    |
|--------------|---|--------------------|
| 1 Domestic   | 5 Public Water Supply                                     | 9 Dewatering       |
| 2 Irrigation | 6 <input checked="" type="radio"/> Oil Field Water Supply | 10 Monitoring Well |
| 3 Feedlot    | 7 Lawn and Garden (domestic)                              | 11 Injection Well  |
| 4 Industrial | 8 Air Conditioning  | 12 Other           |

Was a chemical/bacteriological sample submitted to Department? Yes \_\_\_ No

If yes, mo/day/yr sample was submitted \_\_\_\_\_

Water Well Disinfected: Yes  No \_\_\_

5 TYPE OF BLANK CASING USED:

1 Steel	3 RMP (SR)	5 Wrought	7 Fiberglass	9 Other (specify below)
2 PVC	4 ABC	6 Asbestos-Cement	8 Concrete Tile	

Blank casing diameter **4.5** in. Was casing pulled? Yes \_\_\_ No  If yes, how much \_\_\_\_\_

Casing height above or below land surface **-36** in.

6 GROUT PLUG MATERIAL: 1 Neat cement 2 Cement grout 3 Bentonite 4 Other

Grout Plug Intervals From **0** ft. to **3** ft. From **126** ft. to **129** ft. From \_\_\_\_\_ ft. to \_\_\_\_\_ ft.

- What is the nearest source of possible contamination:
- |                          |                   |                         |                          |
|--------------------------|-------------------|-------------------------|--------------------------|
| 1 Septic tank            | 6 Seepage pit     | 11 Fuel storage         | 16 Other (specify below) |
| 2 Sewer lines            | 7 Pit privy       | 12 Fertilizer storage   |                          |
| 3 Watertight sewer lines | 8 Sewage lagoon   | 13 Insecticide storage  |                          |
| 4 Lateral lines          | 9 Feedyard        | 14 Abandoned water well |                          |
| 5 Cess Pool              | 10 Livestock pens | 15 Oil well/ Gas well   |                          |

Direction from well? \_\_\_\_\_ How many feet? \_\_\_\_\_

FROM	TO	CODE	PLUGGING MATERIALS
0	3		Clay
3	6		Bentonite
6	126		Clay
126	129		Bentonite
129	215		Chlorinated Sand

7 CONTRACTOR'S OR LANDOWNER'S CERTIFICATION: This water well was plugged under my jurisdiction and was completed on (mo/day/yr) **3/18/09** and this record is true to the best of my knowledge and belief. Kansas Water Well Contractor's License No. **783** This Water Well Record was completed on (mo/day/yr) **3/24/09** under the business name of **Woofter Pump & Well, Inc.** by (signature) *[Signature]*

INSTRUCTIONS: Please fill in blanks and circle the correct answers. Send three copies to Kansas Department of Health and Environment, Bureau of Water, 1000 S W Jackson St., Ste. 420, Topeka, Kansas 66620-0001. Telephone: 785-296-3565. Send one to Water Well Owner and retain one for your records.