


1 LOCATION OF WATER WELL: County: <u>Logan</u>	Fraction <u>NE ¼ NE ¼SW ¼</u>	Section Number <u>24</u>	Township Number <u>12</u>	Range Number <u>35 E/W</u>
--	----------------------------------	-----------------------------	------------------------------	-------------------------------

Distance and direction from nearest town or city street address of well if located within city?
7 miles S., ½ W., ¼N. of Page City, KS

2 WATER WELL OWNER: <u>ECO Farms/ Steve & Scott Schertz</u> RR#, St. Address, Box #: <u>2503 Co. Rd. 270</u> City, State ZIP Code: <u>Monument, KS 67747</u>	Global Positioning Systems (decimal degrees, min. of 4 digits) Latitude: _____ Longitude: _____ Elevation: _____ Datum: _____ Data Collection Method: _____
--	---

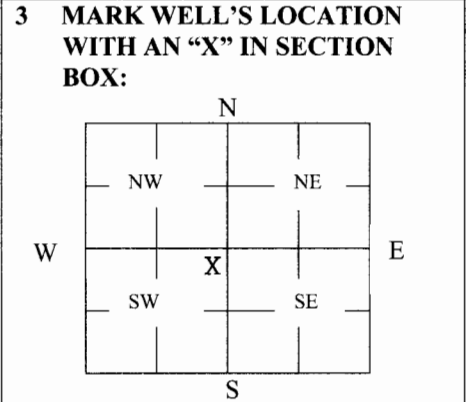

4 DEPTH OF WELL 142 ft.
WELL'S STATIC WATER LEVEL 110 ft.
WELL WAS USED AS:

<u>1 Domestic X</u>	5 Public Water Supply	9 Dewatering
2 Irrigation	6 Oil Field Water Supply	10 Monitoring
3 Feedlot	7 Domestic (Lawn & Garden)	11 Injection Well
4 Industrial	8 Air Conditioning	12 Other _____

Was a chemical/bacteriological sample submitted to Department? Yes _____ No X

5 TYPE OF BLANK CASING USED:

1 Steel <u>X</u>	3 RMP (SR)	5 Wrought	7 Fiberglass	9 Other (Specify below)
2 PVC	4 ABS	6 Asbestos-Cement	8 Concrete Tile	_____

Blank casing diameter 5 in. Was casing pulled? Yes X No _____ If yes, how much 23'
 Casing height above or below land surface 240 in.

6 GROUT PLUG MATERIAL: 1 Neat cement X 2 Cement grout 3 Bentonite 4 Other _____

Grout Plug Intervals: From 110 ft. to 100 ft., From 30 ft. to 20 ft., From _____ to _____ ft.

What is the nearest source of possible contamination:

1 Septic tank	6 Seepage pit	11 Fuel Storage	16 Other (specify below) <u>X</u>
2 Sewer lines	7 Pit privy	12 Fertilizer storage	<u>pasture</u>
3 Watertight sewer lines	8 Sewage lagoon	13 Insecticide storage	
4 Lateral lines	9 Feedyard	14 Abandoned water well	Direction from well? <u>all around</u>
5 Cess pool	10 Livestock pens	15 Oil well/Gas well	How many feet? _____

FROM	TO	PLUGGING MATERIALS	FROM	TO	PLUGGING MATERIALS
142	110	gravel			
110	100	neat cement			
100	30	clean soil			
30	20	neat cement			
20	0	clean soil			

7 CONTRACTOR'S OR LANDOWNER'S CERTIFICATION: This water well was plugged under my jurisdiction and was completed on (mo/day/year) 12-01-09 and this record is true to the best of my knowledge and belief. Kansas Water Well Contractor's License No. 649. This Water Well Record was completed on (mo/day/year) 3-31-10 under the business name of Bartell Drilling by (signature) Daylene Bartell

INSTRUCTIONS: Use typewriter or ballpoint pen. Please press firmly and print clearly. Please fill in blanks, underline or circle the correct answers. Send top three copies to Kansas Department of Health and Environment, Bureau of Water, Geology Section, 1000 SW Jackson St., Ste. 420, Topeka, Kansas 66612-1367. Telephone: 785/296-5522. Send one to Water Well Owner and retain one for your records. Visit us at <http://www.kdheks.gov/geo/waterwells>.