

corrected

WATER WELL RECORD Form WWC-5


Original Record Correction Change in Well Use

Division of Water Resources App. No.

Well ID

1 LOCATION OF WATER WELL: County: Logan Fraction: NE 1/4 NE 1/4 NE 1/4 NE 1/4 Section Number: 19 Township Number: T 12 S Range Number: R 36 E

2 WELL OWNER: Last Name: Summers First: Wright Address: Block Rock Res. City: Russell State: Ks ZIP: Street or Rural Address where well is located (if unknown, distance and direction from nearest town or intersection): 2 E 15 of McCauley, Ks

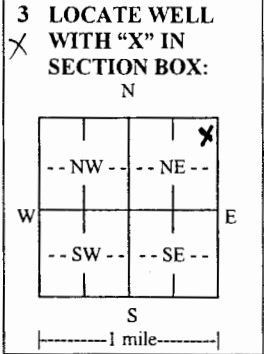

3 LOCATE WELL WITH "X" IN SECTION BOX: N
4 DEPTH OF COMPLETED WELL: 16 ft. Depth(s) Groundwater Encountered: 1) 8 ft. 2) ft. 3) ft. or 4) Dry Well WELL'S STATIC WATER LEVEL: 8 ft. below land surface, measured on (mo-day-yr) above land surface, measured on (mo-day-yr) Pump test data: Well water was 8 ft. after hours pumping gpm Well water was ft. after hours pumping gpm Estimated Yield: 50 gpm Bore Hole Diameter: 9 in. to 16 ft. and in. to ft.

5 Latitude: (decimal degrees) Longitude: (decimal degrees) Horizontal Datum: WGS 84 NAD 83 NAD 27 Source for Latitude/Longitude: GPS (unit make/model:) (WAAS enabled? Yes No) Land Survey Topographic Map Online Mapper:
6 Elevation: ft. Ground Level TOC Source: Land Survey GPS Topographic Map Other

7 WELL WATER TO BE USED AS:
1. Domestic: Household Lawn & Garden Livestock Irrigation Feedlot Industrial
2. Public Water Supply: well ID
3. Dewatering: how many wells?
4. Aquifer Recharge: well ID
5. Monitoring: well ID
6. Environmental Remediation: well ID
7. Air Sparge Soil Vapor Extraction Recovery Injection
8. Oil Field Water Supply: lease Summers
9. Test Hole: well ID
10. Cased Uncased Geotechnical
11. Geothermal: how many bores?
a) Closed Loop Horizontal Vertical
b) Open Loop Surface Discharge Inj. of Water
12. Other (specify):

Was a chemical/bacteriological sample submitted to KDHE? Yes No If yes, date sample was submitted:
Water well disinfected? Yes No

8 TYPE OF CASING USED: Steel PVC Other CASING JOINTS: Glued Clamped Welded Threaded
Casing diameter 5 in. to 16 in. Diameter in. to ft. Diameter in. to ft.
Casing height above land surface 12 in. Weight 250 lbs./ft. Wall thickness or gauge No. 250
TYPE OF SCREEN OR PERFORATION MATERIAL: Steel Stainless Steel Fiberglass PVC Other (Specify)
 Brass Galvanized Steel Concrete tile None used (open hole)
SCREEN OR PERFORATION OPENINGS ARE:
 Continuous Slot Mill Slot Gauze Wrapped Torch Cut Drilled Holes Other (Specify)
 Louvered Shutter Key Punched Wire Wrapped Saw Cut None (Open Hole)
SCREEN-PERFORATED INTERVALS: From 8 ft. to 16 ft., From ft. to ft., From ft. to ft.
GRAVEL PACK INTERVALS: From 7 ft. to 16 ft., From ft. to ft., From ft. to ft.

9 GROUT MATERIAL: Neat cement Cement grout Bentonite Other
Grout Intervals: From 0 ft. to 7 ft., From ft. to ft., From ft. to ft.
Nearest source of possible contamination:
 Septic Tank Lateral Lines Pit Privy Livestock Pens Insecticide Storage
 Sewer Lines Cess Pool Sewage Lagoon Fuel Storage Abandoned Water Well
 Watertight Sewer Lines Seepage Pit Feedyard Fertilizer Storage Oil Well/Gas Well
 Other (Specify) River Channel
Direction from well? East Distance from well? 500 ft.

10 FROM	TO	LITHOLOGIC LOG	FROM	TO	LITHO. LOG (cont.) or PLUGGING INTERVALS
<u>0</u>	<u>2</u>	<u>Clay</u>			
<u>2</u>	<u>16</u>	<u>Gravel</u>			

11 CONTRACTOR'S OR LANDOWNER'S CERTIFICATION: This water well was constructed, reconstructed, or plugged under my jurisdiction and was completed on (mo-day-year) 2-18 and this record is true to the best of my knowledge and belief. Kansas Water Well Contractor's License No. 376 This Water Well Record was completed on (mo-day-year) 2-18 under the business name of B. B. Drilling, LLC Signature Joseph Beckman

Original Returned to Sender for Correction Date: 5/19/18