

USE TYPEWRITER OR BALL  
POINT PEN-PRESS FIRMLY,  
PRINT CLEARLY.

T R EW sec 1/4 1/4 1/4 No.


WATER WELL RECORD  
KSA 82a-1201-1215

Kansas State Dept. Of Health  
(Water Well Contractors)  
Forbes-Bldg. 740  
Topeka, Kansas 66620

1 Location of well:	County <b>Ottawa</b>	Township name	Fraction <b>NW NW</b>	Section number <b>14</b>	Town number <b>125</b>	Range number <b>4W</b>
---------------------	-------------------------	---------------	--------------------------	-----------------------------	---------------------------	---------------------------

Distance and direction from nearest town or city: **7 Mi. E of Tescott** 3 Owner of well: **Ray Elmore**

Street address of well location if in city: \_\_\_\_\_ Address: **Bennington Kans**

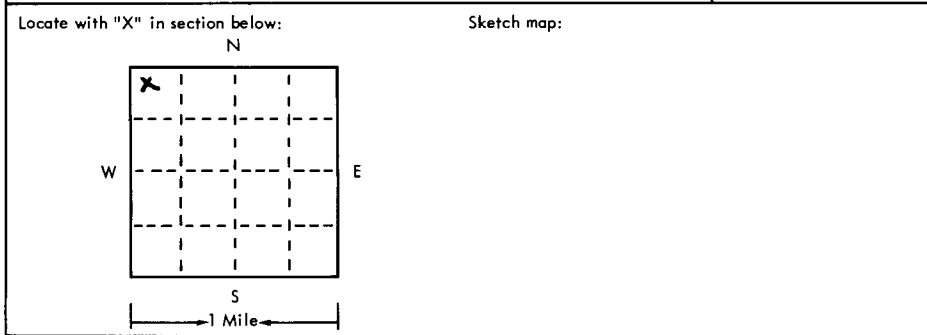

4 Well depth: **100** ft. Date of completion **4-16-75**  
Well diameter **4"** in.

5  Cable tool  Rotary  Driven  Dug  
 Hollow rod  Jetted  Bored  Reverse rotary

6 Use:  Domestic  Public supply  Industry  
 Irrigation  Air conditioning  Commercial  
 Test well  \_\_\_\_\_

7 Casing: Material **PVC** Height:  above /  below  
Threaded  Welded  Surface **12** in.  
Diam. \_\_\_\_\_ Weight \_\_\_\_\_ lbs./ft. \_\_\_\_\_  
**4** in. to **100** ft. depth Drive shoe?  Yes  No  
\_\_\_\_\_ in. to \_\_\_\_\_ ft. depth!

2	Type and color of material	From	To
	Clay, grey & tan	0	7
	Shale, clayey, red, yellow, & shaly grey	7	75
	Sandstone, fine, silty, lt. grey	75	82
	Shale, dark grey	82	95
	Sandstone, fine, white	95	98
	Shale, dark grey	98	106
	(use a second sheet if needed)		

8 Screen:  
Manufacturer **Skop**  
Type **PVC** Dia. **4"**  
Slot/gauze **3/32** Length \_\_\_\_\_  
Set between **79** ft. and **82** ft. \_\_\_\_\_  
Fittings: **+95 - 98**  
Gravel pack  Yes  No Size range of material **1/4"**

9 Static water level:  
**50** ft. below land surface Date **4-16-75**

10 Pumping level below land surfaces:  
\_\_\_\_\_ ft. after \_\_\_\_\_ hrs. pumping \_\_\_\_\_ g.p.m.  
\_\_\_\_\_ ft. after \_\_\_\_\_ hrs. pumping \_\_\_\_\_ g.p.m.  
Estimated maximum yield **5** g.p.m.

11 Water sample submitted:  
 Yes  No Date \_\_\_\_\_

12 Well head completion:  
 Pitless adapter  Inches above grade

13 Well grouted?  Yes  No  
 Neat cement  Bentonite  \_\_\_\_\_  
Depth: From **0** ft. to **10** ft.

14 Nearest source of possible contamination:  
ft. \_\_\_\_\_ Direction \_\_\_\_\_ Type \_\_\_\_\_  
Well disinfected upon completion?  Yes  No

15 Pump:  Not installed  
Manufacturer's name \_\_\_\_\_  
Model number \_\_\_\_\_ HP \_\_\_\_\_ Volts \_\_\_\_\_  
Length of drop pipe \_\_\_\_\_ ft. capacity \_\_\_\_\_ g.m.p.  
Type:  
 Submersible  Turbine  
 Jet  Reciprocating  
 Centrifugal  Other

16 Remarks: elevation

Topography:  
 Hill  
 Slope  
 Upland  
 Valley

17 Water well contractor's certification:  
This well was drilled under my jurisdiction and this report is true to the best of my knowledge and belief.

**Hydraulic Drilling** **126**  
Business name License No.  
Address **Salina, Kas**  
Signed **D. J. Faust** Date **5-14-75**  
Authorized representative