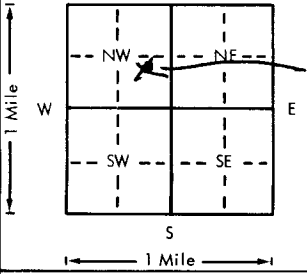


USE TYPEWRITER OR BALL POINT PEN—PRESS FIRMLY, PRINT CLEARLY.

WATER WELL RECORD
KSA 82a-1201-1215

Kansas Department of Health and Environment—Division of Environment (Water well Contractors) Topeka, Kansas 66620

1. Location of well: County OTTAWA		Fraction NW 1/4 SE 1/4 NW 1/4		Section number 18		Township number T 12 S R 4		Range number 4		
2. Distance and direction from nearest town or city: 3 1/2 mi. EAST OF TESCOTT, Ks.					3. Owner of well: BOB MINNIMAN R.R. or street: R.R. City, state, zip code: TESCOTT Ks.					
4. Locate with "X" in section below: 					Sketch map: DOMESTIC WELL					
5. Type and color of material					From		To		6. Bore hole dia. 8 in. Completion date 12-29-78 Well depth 40 ft.	
Top Soil					0		5		7. <input checked="" type="checkbox"/> Cable tool <input checked="" type="checkbox"/> Rotary <input type="checkbox"/> Driven <input type="checkbox"/> Dug <input type="checkbox"/> Hollow rod <input type="checkbox"/> Jetted <input type="checkbox"/> Bored <input type="checkbox"/> Reverse rotary	
FINE RED SANDY CLAY					5		13		8. Use: <input checked="" type="checkbox"/> Domestic <input type="checkbox"/> Public supply <input type="checkbox"/> Industry <input type="checkbox"/> Irrigation <input type="checkbox"/> Air conditioning <input type="checkbox"/> Stock <input type="checkbox"/> Lawn <input type="checkbox"/> Oil field water <input type="checkbox"/> Other	
FINE RED SAND					13		18		9. Casing: Material _____ Height Above or below Threaded _____ Welded _____ Surface 18 in. RMP _____ PVC <input checked="" type="checkbox"/> Weight 2 lbs./ft. Dia. 4 in. to 20 ft. depth Wall Thickness: inches or Dia. 4 in. to 40 ft. depth gage No. .25 in	
CREEK GRAVEL					18		24		10. Screen: Manufacturer's name PEERLESS PLASTICS Type PVC Dia. 4 1/4 Slot/gauze 1/32 Length 10 ft Set between 20 ft. and 30 ft. _____ ft. and _____ ft. Gravel pack? YES Size range of material 1/4 in	
SANDSTONE					24		28		11. Static water level: _____ mo./day/yr. 13 ft. below land surface Date 12-29-78	
BLUE SHALE					28		40		12. Pumping level below land surfaces: 20 ft. after 12 hrs. pumping 12 g.p.m. _____ ft. after _____ hrs. pumping _____ g.p.m. Estimated maximum yield 15 g.p.m.	
									13. Water sample submitted: _____ mo./day/yr. <input type="checkbox"/> Yes <input checked="" type="checkbox"/> No Date _____	
									14. Well head completion: <input type="checkbox"/> Pitless adapter 18 Inches above grade	
									15. Well grouted? YES With: <input checked="" type="checkbox"/> Neat cement <input type="checkbox"/> Bentonite <input type="checkbox"/> Concrete Depth: From 0 ft. to 10 ft.	
									16. Nearest source of possible contamination: ft. 150 Direction EAST Type SEWER Well disinfected upon completion? <input checked="" type="checkbox"/> Yes <input type="checkbox"/> No	
									17. Pump: <input checked="" type="checkbox"/> Not installed Manufacturer's name _____ Model number _____ HP _____ Volts _____ Length of drop pipe _____ ft. capacity _____ g.p.m. Type: <input type="checkbox"/> Submersible <input type="checkbox"/> Turbine <input type="checkbox"/> Jet <input type="checkbox"/> Reciprocating <input type="checkbox"/> Centrifugal <input type="checkbox"/> Other	
(Use a second sheet if needed)										
18. Elevation: 2100		19. Remarks:						20. Water well contractor's certification: This well was drilled under my jurisdiction and this report is true to the best of my knowledge and belief. PETERSON IRRIGATION 138 Business name License No. Address Box 150 LINDSBURG, Ks Signed Mike Peterson Date 1-3-79 Authorized representative		
Topography: <input type="checkbox"/> Hill <input type="checkbox"/> Slope <input checked="" type="checkbox"/> Upland <input type="checkbox"/> Valley										

T 12 S R 4 NW 1/4 18 NW 1/4

Forward the white, blue and pink copies to the Department of Health and Environment

Form WWC-5