


1	LOCATION OF WATER WELL: County: <u>Ottawa</u>	Fraction <u>SE 1/4 SE 1/4 SE 1/4</u>	Section Number <u>16</u>	Township Number <u>12</u>	Range Number <u>4 W</u>
---	--	---	-----------------------------	------------------------------	----------------------------

Distance and direction from nearest town or city street address of well if located within city?  
Two Miles North of Culver, Kansas

2 WATER WELL OWNER: Bruce Srna  
 RR#, St. Address, Box #: 893 Coronado Rd. Board of Agriculture, Division of Water Resources  
 City, State, ZIP Code : Culver 67494 Application Number:

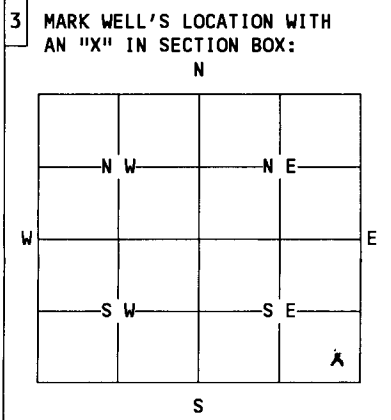

4 DEPTH OF WELL.....25.....ft.  
 WELL'S STATIC WATER LEVEL.....10.....ft.  
 WELL WAS USED AS:  
 1 Domestic      5 Public Water Supply      9 Dewatering  
 2 Irrigation    6 Oil Field Water Supply    10 Monitoring Well  
 3 Feedlot      7 Lawn and Garden Only    11 Injection Well  
 4 Industrial    8 Air Conditioning          12 Other.....PASTURE

Was a chemical/bacteriological sample submitted to Department? Yes....NoX...  
 If yes, mo/day/yr sample was submitted.....  
 Water Well Disinfected: Yes..X.. No.....

5 TYPE OF BLANK CASING USED:  
 1 Steel    3 RMP (SR)    5 Wrought    7 Fiberglass    9 Other (specify below) Pipe Removed  
 2 PVC    4 ABS        6 Asbestos-Cement    8 Concrete Tile

Blank casing diameter.....2.....in.    Was casing pulled? Yes..X... No..... If yes, how much.....  
 Casing height above or below land surface.....in.

6 GROUT PLUG MATERIAL: 1 Neat cement    2 Cement grout    3 Bentonite    4 Other 10' Blue Clay  
 Grout Plug Intervals: From..5..ft. to..5..ft., From..5..ft. to..10..ft., From..... to.....ft.  
 What is the nearest source of possible contamination:  
 1 Septic tank                      6 Seepage pit                      11 Fuel storage                      16 Other (specify below)  
 2 Sewer lines                      7 Pit privy                      12 Fertilizer storage  
 3 Watertight sewer lines        8 Sewage lagoon                    13 Insecticide storage  
 4 Lateral lines                      9 Feedyard                      14 Abandoned water well  
 5 Cess Pool                      10 Livestock pens                    15 Oil well/Gas well

Direction from well? So. West                      How many feet? 200'

FROM	TO	PLUGGING MATERIALS
	5'	Rock
	5'	sand
	5'	Rock
	10'	Blue Clay
		3 Gallons Chlorine

old septic Tank was removed  
Well was pumped dry.

7 CONTRACTOR'S OR LANDOWNER'S CERTIFICATION: This water well was plugged under my jurisdiction and was completed on (mo/day/year) 4-17-98 and this record is true to the best of my knowledge and belief. Kansas Water Well Contractor's License No. .... This Water Well Record was completed on (mo/day/year) 4-21-98 under the business name of ..... by (signature) D. S. Cobb ..... Donald H. Cobb .....

INSTRUCTIONS: Use typewriter or ball point pen. Please press firmly and print clearly. Please fill in blanks, underline or circle the correct answers. Send top three copies to Kansas Department of Health and Environment, Bureau of Water, Topeka, Kansas 66620-0001. Telephone: 913/296-3565. Send one to Water Well Owner and retain one for your records.