

**CORRECTION(S) TO WATER WELL RECORD (Form WWC-5)**

(to rectify lacking or incorrect information)

<b>LOCATION OF WATER WELL:</b> County: <u>Ottawa</u>	Fraction <u>NE</u> ¼ <u>SE</u> ¼ <u>SW</u> ¼ _____ ¼	Section <u>35</u>	Township T <u>12</u> S	Range R <u>4</u> <input type="checkbox"/> E <input checked="" type="checkbox"/> W
---	---	----------------------	---------------------------	--

**Owner:** Grant Gotti

**Location was listed as:**

Sec. \_\_\_\_\_ T \_\_\_\_\_ S R \_\_\_\_\_ E W

Fraction: \_\_\_\_\_

**Location changed to:**

Sec. \_\_\_\_\_ T \_\_\_\_\_ S R \_\_\_\_\_ E W

Fraction: \_\_\_\_\_

**Other changes:** Initial statements: County reported as Saline.

Written location was from a location on another well constructed by driller in Reno Co.

Changed to: Well is in Ottawa Co., just north of Saline/Ottawa county line.

Address of well: 10 N 100th Rd, Culver (per other Gotti irrigation well in same quarter section).

Comments: \_\_\_\_\_

Verification method: WWC5 database, Google Earth using Driller submitted coordinates.

\_\_\_\_\_ initials: DLS date: 6/18/2015

Submitted by: Kansas Geological Survey, Data Resources Library, 1930 Constant Ave., Lawrence, KS 66047-3726  
to: Kansas Dept of Health & Environment, Bureau of Water, 1000 SW Jackson, Suite 420, Topeka, KS 66612-1367.

**WATER WELL RECORD**

**Form WWC-5**

Division of Water Resources App. No.


49216

<b>1 LOCATION OF WATER WELL:</b> County: <u>Saline</u>	Fraction <u>NE 1/4 SE 1/4 SW 1/4 SW 1/4</u>	Section Number <u>35</u>	Township No. <u>T 12 S</u>	Range Number <u>R 4</u> <input type="checkbox"/> E <input checked="" type="checkbox"/> W
---	--	-----------------------------	-------------------------------	---

Street/Rural Address of Well Location; if unknown, distance & direction from nearest town or intersection: If at owner's address, check here .  
96 Hwy to 1/4E of Nickerson (Riverton Rd.) 2N ESR

**Global Positioning System (GPS) information:**  
 Latitude: 38.95904 (in decimal degrees)  
 Longitude: 097.73834 (in decimal degrees)  
 Elevation: 1265  
 Datum:  WGS 84,  NAD 83,  NAD 27  
 Collection Method:  
 GPS unit (Make/Model: Garmin 62S)  
 Digital Map/Photo,  Topographic Map,  Land Survey  
 Est. Accuracy:  <3 m,  3-5 m,  5-15 m,  >15 m

**2 WATER WELL OWNER:** Grant Gotti  
 RR#, Street Address, Box #: 10 N. 100th Rd.  
 City, State, ZIP Code : Culver, Kansas 67484

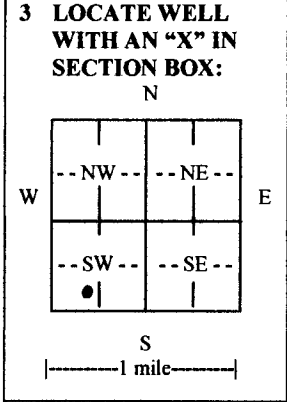

**4 DEPTH OF COMPLETED WELL** 57 ft.

Depth(s) Groundwater Encountered (1)..... ft. (2)..... ft. (3)..... ft.

WELL'S STATIC WATER LEVEL 24 ft. below land surface measured on mo/day/yr. 4/14/2015

Pump test data: Well water was.....ft. after..... hours pumping..... gpm

EST. YIELD.....gpm. Well water was.....ft. after..... hours pumping..... gpm

Bore Hole Diameter 16 in. to 39 ft., and .....in. to .....ft.

WELL WATER TO BE USED AS:  Public water supply  Geothermal  Injection well  
 Domestic  Feedlot  Oil field water supply  Dewatering  Other (Specify below)  
 Irrigation  Industrial  Domestic-lawn & garden  Monitoring well

Was a chemical/bacteriological sample submitted to Department?  Yes  No

If yes, mo/day/yr sample was submitted.....

Water well disinfected?  Yes  No

**5 TYPE OF CASING USED:**  Steel  PVC  Other

CASING JOINTS:  Glued  Clamped  Welded  Threaded

Casing diameter 8 in. to 39 ft., Diameter 8 in. to 52-57 ft., Diameter ..... in. to ..... ft.

Casing height above land surface 16 in., Weight 160 lbs./ft., Wall thickness or gauge No. 332

TYPE OF SCREEN OR PERFORATION MATERIAL:  
 Steel  Stainless Steel  PVC  Other (Specify) .....  
 Brass  Galvanized Steel  None used (open hole)

SCREEN OR PERFORATION OPENINGS ARE:  
 Continuous slot  Mill slot  Gauze wrapped  Torch cut  Drilled holes  None (open hole)  
 Louvered shutter  Key punched  Wire wrapped  Saw cut  Other (specify) .....

SCREEN-PERFORATED INTERVALS: From 39 ft. to 52 ft., From ..... ft. to ..... ft.

GRAVEL PACK INTERVALS: From 57 ft. to 20 ft., From ..... ft. to ..... ft.

**6 GROUT MATERIAL:**  Neat cement  Cement grout  Bentonite  Other

Grout Intervals: From 20 ft. to 0 ft., From ..... ft. to ..... ft., From ..... ft. to ..... ft.

What is the nearest source of possible contamination:  
 Septic tank  Lateral lines  Pit privy  Livestock pens  Insecticide storage  Other (specify below)  
 Sewer lines  Cesspool  Sewage lagoon  Fuel storage  Abandoned water well  
 Watertight sewer lines  Seepage pit  Feedyard  Fertilizer storage  Oil well/gas well Irrigation well

Direction from well SW Distance from well 300'

FROM	TO	LITHOLOGIC LOG	FROM	TO	LITHO. LOG (cont.) or PLUGGING INTERVALS
0	3	Top soil			
3	14	Brown clay			
14	22	Tan clay-silty			
24	31	Fine-small sand			
31	45	Small-coarse sand			
45	58	Shale			

**7 CONTRACTOR'S OR LANDOWNER'S CERTIFICATION:** This water well was  constructed,  reconstructed, or  plugged under my jurisdiction and was completed on (mo/day/year) 4/14/2014 and this record is true to the best of my knowledge and belief. Kansas Water Well Contractor's License No. 134 This Water Well Record was completed on (mo/day/year) 4/21/2015 under the business name of Rosencrantz-Bemis Ent. by (signature) [Signature]

**INSTRUCTIONS:** Use typewriter or ball point pen. PLEASE PRESS FIRMLY and PRINT clearly. Please fill in blanks and check the correct answers. Send three copies (white, blue, pink) to Kansas Department of Health and Environment, Bureau of Water, Geology Section, 1000 SW Jackson St., Suite 420, Topeka, Kansas 66612-1367. Telephone 785-296-5524. Send one copy to WATER WELL OWNER and retain one for your records. Include fee of \$5.00 for each constructed well. Visit us at <http://www.kdheks.gov/waterwell/index.html>.