


1 LOCATION OF WATER WELL: Fraction Section Number Township Number Range Number
 County: Wallace SW 1/4 SW 1/4 SW 1/4 31 T 12 S R 41 EW

Distance and direction from nearest town or city street address of well if located within city?
 6 miles north 3 miles east of Weskan

2 WATER WELL OWNER: Jesse Craft
 P.O. Box # : 739 W 31 Board of Agriculture, Division of Water Resources
 City, State, ZIP Code : Goodland, KS 67735 Application Number:

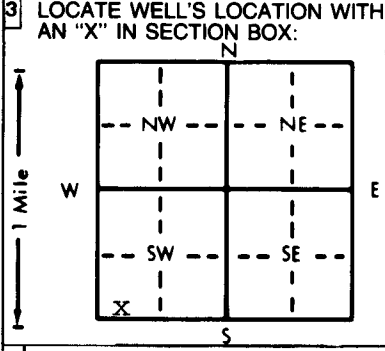

4 DEPTH OF COMPLETED WELL... 150... ft. ELEVATION: ...
 Depth(s) Groundwater Encountered 1. ft. 2. ft. 3. ft.
 WELL'S STATIC WATER LEVEL ... 100... ft. below land surface measured on mo/day/yr ... 8-1-95...
 Pump test data: Well water was ft. after hours pumping gpm
 Est. Yield gpm: Well water was ~~not tested~~ ft. after hours pumping gpm
 Bore Hole Diameter 8... in. to ... 150... ft., and in. to ft.
 WELL WATER TO BE USED AS: 5 Public water supply 8 Air conditioning 11 Injection well
 1 Domestic 3 Feedlot 6 Oil field water supply 9 Dewatering 12 Other (Specify below)
 2 Irrigation 4 Industrial 7 Lawn and garden only 10 Monitoring well
 Was a chemical/bacteriological sample submitted to Department? Yes.....No........; If yes, mo/day/yr sample was submitted
 Water Well Disinfected? Yes No

5 TYPE OF BLANK CASING USED: 5 Wrought iron 8 Concrete tile CASING JOINTS: Glued Clamped
 1 Steel 3 RMP (SR) 6 Asbestos-Cement 9 Other (specify below) Welded
 2 PVC 4 ABS 7 Fiberglass Threaded
 Blank casing diameter . 5... in. to ... 130... ft., Dia ... in. to ... ft., Dia ... in. to ... ft.
 Casing height above land surface ... 18... in., weight ... 2.6... lbs./ft. Wall thickness or gauge No. 1/4"
 TYPE OF SCREEN OR PERFORATION MATERIAL: 7 PVC 10 Asbestos-cement
 1 Steel 3 Stainless steel 5 Fiberglass 8 RMP (SR) 11 Other (specify)
 2 Brass 4 Galvanized steel 6 Concrete tile 9 ABS 12 None used (open hole)
 SCREEN OR PERFORATION OPENINGS ARE: 5 Gauzed wrapped 8 Saw cut 11 None (open hole)
 1 Continuous slot 3 Mill slot 6 Wire wrapped 9 Drilled holes
 2 Louvered shutter 4 Key punched 7 Torch cut 10 Other (specify)
 SCREEN-PERFORATED INTERVALS: From ... 130... ft. to ... 150... ft., From ... ft. to ... ft.
 From ... ft. to ... ft., From ... ft. to ... ft.
 GRAVEL PACK INTERVALS: From ... 18... ft. to ... 150... ft., From ... ft. to ... ft.
 From ... ft. to ... ft., From ... ft. to ... ft.

6 GROUT MATERIAL: 1 Neat cement 2 Cement grout 3 Bentonite 4 Other
 Grout Intervals: From ... 4... ft. to ... 18... ft., From ... ft. to ... ft., From ... ft. to ... ft.
 What is the nearest source of possible contamination:
 1 Septic tank 4 Lateral lines 7 Pit privy 10 Livestock pens 14 Abandoned water well
 2 Sewer lines 5 Cess pool 8 Sewage lagoon 11 Fuel storage 15 Oil well/Gas well
 3 Watertight sewer lines 6 Seepage pit 9 Feedyard 12 Fertilizer storage 16 Other (specify below)
 13 Insecticide storage pasture
 Direction from well? How many feet?

FROM	TO	LITHOLOGIC LOG	FROM	TO	PLUGGING INTERVALS
0	42	top Soil			
42	77	sand and sandy strips			
77	108	sand rock and sand strips			
108	119	sand good			
119	127	sand and sand rock strips			
127	138	sandy clay			
138	146	sand and sand rock strips			
146	150	oker and shale			

7 CONTRACTOR'S OR LANDOWNER'S CERTIFICATION: This water well was (1) constructed, (2) reconstructed, or (3) plugged under my jurisdiction and was completed on (mo/day/year) ... 8-1-95... and this record is true to the best of my knowledge and belief. Kansas Water Well Contractor's License No. ... 139... This Water Well Record was completed on (mo/day/yr) ... 8-12-95... under the business name of Bartell Drilling by (signature) *Jay Bartell*

INSTRUCTIONS: Use typewriter or ball point pen. PLEASE PRESS FIRMLY and PRINT clearly. Please fill in blanks, underline or circle the correct answers. Send top three copies to Kansas Department of Health and Environment, Bureau of Water, Topeka, Kansas 66620-0001. Telephone: 913-296-5545. Send one to WATER WELL OWNER and retain one for your records.