


1 LOCATION OF WATER WELL: County: Wallace Fraction: NE 1/4 NE 1/4 SW 1/4 Section Number: 22 Township Number: T 12 S Range Number: R 41 EW

Distance and direction from nearest town or city street address of well if located within city?
25 South Rulston KS.

2 WATER WELL OWNER: Howell Burk -
 RR#, St. Address, Box #: Box 356
 City, State, ZIP Code: Sharon Sps., KS 67758

Board of Agriculture, Division of Water Resources
 Application Number:

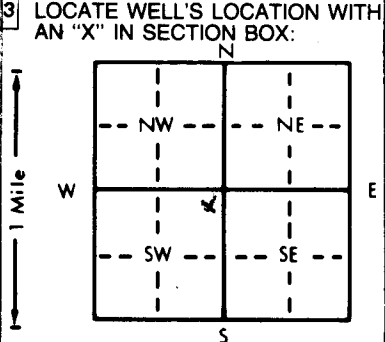

4 DEPTH OF COMPLETED WELL: 38 ft. ELEVATION: 25 ft.
 Depth(s) Groundwater Encountered 1. 25 ft. 2. 38 ft. 3. 38 ft.
 WELL'S STATIC WATER LEVEL 25 ft. below land surface measured on mo/day/yr
 Bore Hole Diameter 8 in. to 38 ft., and 38 in. to 38 ft.
 WELL WATER TO BE USED AS:
 1 Domestic 3 Feedlot 6 Oil field water supply 9 Dewatering 12 Other (Specify below)
 2 Irrigation 4 Industrial 7 Lawn and garden only 10 Monitoring well
 Was a chemical/bacteriological sample submitted to Department? Yes X No ; If yes, mo/day/yr sample was submitted
 Water Well Disinfected? Yes No

5 TYPE OF BLANK CASING USED:
 1 Steel 3 RMP (SR) 5 Wrought iron 8 Concrete tile
 2 PVC 4 ABS 7 Fiberglass 9 Other (specify below)
 Blank casing diameter 4.5 in. to 12 ft., Dia 100 lbs./ft. Wall thickness or gauge No. SDR 26
 Casing height above land surface 12 in., weight 100 lbs./ft.
 TYPE OF SCREEN OR PERFORATION MATERIAL:
 1 Steel 3 Stainless steel 5 Fiberglass 8 RMP (SR) 10 Asbestos-cement
 2 Brass 4 Galvanized steel 6 Concrete tile 9 ABS 11 Other (specify)
 SCREEN OR PERFORATION OPENINGS ARE:
 1 Continuous slot 3 Mill slot 5 Gauzed wrapped 8 Saw cut 11 None (open hole)
 2 Louvered shutter 4 Key punched 7 Torch cut 10 Other (specify)
 SCREEN-PERFORATED INTERVALS: From 20 ft. to 38 ft., From ft. to ft.
 GRAVEL PACK INTERVALS: From 20 ft. to 38 ft., From ft. to ft.
8-12 Silica Sand
Returns

6 GROUT MATERIAL: 1 Neat cement 2 Cement grout 3 Bentonite 4 Other
 Grout Intervals: From 0 ft. to 20 ft., From ft. to ft., From ft. to ft.
 What is the nearest source of possible contamination:
 1 Septic tank 4 Lateral lines 7 Pit privy 10 Livestock pens 14 Abandoned water well
 2 Sewer lines 5 Cess pool 8 Sewage lagoon 11 Fuel storage 15 Oil well/Gas well
 3 Watertight sewer lines 6 Seepage pit 9 Feedyard 12 Fertilizer storage 16 Other (specify below)
 13 Insecticide storage
 Direction from well? None in sight How many feet? OPEN PASTURE

FROM	TO	LITHOLOGIC LOG	FROM	TO	PLUGGING INTERVALS
0	10	Overburden			
10	28	Sand and gravel			
28	38	Shale			

7 CONTRACTOR'S OR LANDOWNER'S CERTIFICATION: This water well was (1) constructed, (2) reconstructed, or (3) plugged under my jurisdiction and was completed on (mo/day/year) 5-25-92 and this record is true to the best of my knowledge and belief. Kansas Water Well Contractor's License No. 484 This Water Well Record was completed on (mo/day/yr) 10-2-92 under the business name of Schaal Drilling Co. by (signature) Robert Schaal