

1 LOCATION OF WATER WELL: County: <u>Ottawa</u>	Fraction: <u>SE 1/4 SW 1/4 SE 1/4</u>	Section Number: <u>26</u>	Township Number: <u>T 12 S</u>	Range Number: <u>R 5W E/W</u>
---	---------------------------------------	---------------------------	--------------------------------	-------------------------------

Distance and direction from nearest town or city street address of well if located within city?


1 1/2S, 1E of Tescott, Ks.

2 WATER WELL OWNER: Ralph Larson

RR#, St. Address, Box # : 106 N. 40 Road
City, State, ZIP Code : Tescott, Ks. 67484

Board of Agriculture, Division of Water Resources
Application Number:

3 LOCATE WELL'S LOCATION WITH AN "X" IN SECTION BOX: 4 DEPTH OF COMPLETED WELL... 43 ft. ELEVATION: unknown

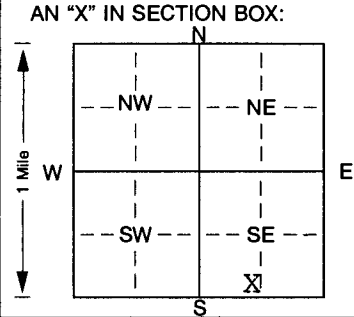

Depth(s) Groundwater Encountered 1... 28 ft. 2... ft. 3... ft.

WELL'S STATIC WATER LEVEL... 29 ft. below land surface measured on mo/day/yr 05/15/02

Pump test data: Well water was ... ft. after ... hours pumping ... gpm

Est. Yield ... 15 gpm: Well water was ... ft. after ... hours pumping ... gpm

Bore Hole Diameter... 8 in. to 43 ft., and... in. to ... ft.

WELL WATER TO BE USED AS: 5 Public water supply 8 Air conditioning 11 Injection well
1 Domestic 3 Feedlot 6 Oil field water supply 9 Dewatering 12 Other (Specify below)
2 Irrigation 4 Industrial 7 Domestic (lawn & garden) 10 Monitoring well

Was a chemical/bacteriological sample submitted to Department? Yes... No...; If yes, mo/day/yr sample was submitted
Water Well Disinfected? Yes No

5 TYPE OF BLANK CASING USED: 5 Wrought iron 8 Concrete tile CASING JOINTS: Glued Clamped

1 Steel 3 RMP (SR) 6 Asbestos-Cement 9 Other (specify below) Welded
2 PVC 4 ABS 7 Fiberglass Threaded

Blank casing diameter... 5 in. to 23 ft., Dia... in. to ... ft., Dia... in. to ... ft.

Casing height above land surface... 12 in., weight... 2.8 lbs./ft. Wall thickness or gauge No. Sch. 40

TYPE OF SCREEN OR PERFORATION MATERIAL: 7 PVC 10 Asbestos-cement

1 Steel 3 Stainless steel 5 Fiberglass 8 RMP (SR) 11 Other (specify) ...
2 Brass 4 Galvanized steel 6 Concrete tile 9 ABS 12 None used (open hole)

SCREEN OR PERFORATION OPENINGS ARE: 5 Gauzed wrapped 8 Saw cut 11 None (open hole)

1 Continuous slot 3 Mill slot 6 Wire wrapped 9 Drilled holes
2 Louvered shutter 4 Key punched 7 Torch cut 10 Other (specify) ... ft.

SCREEN-PERFORATED INTERVALS: From... 23 ft. to 43 ft., From... ft. to... ft.

GRAVEL PACK INTERVALS: From... 20 ft. to 43 ft., From... ft. to... ft.

6 GROUT MATERIAL: 1 Neat cement 2 Cement grout 3 Bentonite 4 Other

Grout Intervals: From... 0 ft. to 20 ft., From... ft. to... ft., From... ft. to... ft.

What is the nearest source of possible contamination: 10 Livestock pens 14 Abandoned water well

1 Septic tank 4 Lateral lines 7 Pit privy 11 Fuel storage 15 Oil well/Gas well
2 Sewer lines 5 Cess pool 8 Sewage lagoon 12 Fertilizer storage 16 Other (specify below)
3 Watertight sewer lines 6 Seepage pit 9 Feedyard 13 Insecticide storage none - in pasture

Direction from well? How many feet?

FROM	TO	LITHOLOGIC LOG	FROM	TO	PLUGGING INTERVALS
0	2	top soil			
2	28	clay			
28	35	sand and gravel - broken sand rock			
35	43	shale			

7 CONTRACTOR'S OR LANDOWNER'S CERTIFICATION: This water well was (1) constructed, (2) reconstructed, or (3) plugged under my jurisdiction and was

completed on (mo/day/year) 05/15/02 and this record is true to the best of my knowledge and belief. Kansas
Water Well Contractor's Licence No. 186 This Water Well Record was completed on (mo/day/yr) 05/19/02

under the business name of Kelly's Water Well Service, Inc. by (signature) Kathryn R Wood