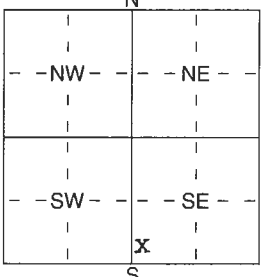


1 LOCATION OF WATER WELL: County: OTTAWA	Fraction SW 1/4 SW 1/4 SE 1/4	Section Number 9	Township Number T 12 S	Range Number R 5W E/W
--	---	----------------------------	----------------------------------	---------------------------------

Distance and direction from nearest town or city street address of well if located within city?
251 K. 18 HWY


2 WATER WELL OWNER: **DEAN LARSON**
 RR#, St. Address, Box # : **251 K. 18 HWY**
 City, State, ZIP Code : **TESCOTT, KS. 67484**
 Board of Agriculture, Division of Water Resources
 Application Number:

3 LOCATE WELL'S LOCATION WITH AN "X" IN SECTION BOX: 	4 DEPTH OF COMPLETED WELL 64 ft. ELEVATION:
	Depth(s) Groundwater Encountered 1 22 ft. 2 ft. 3 ft. WELL'S STATIC WATER LEVEL 22 ft. below land surface measured on mo/day/yr 01-18-05 Pump test data: Well water was 28 ft. after 1 hours pumping 18 gpm Est. Yield 75+ gpm: Well water was ft. after hours pumping gpm WELL WATER TO BE USED AS: 5 Public water supply 8 Air conditioning 11 Injection well 1 Domestic 3 Feedlot 6 Oil field water supply 9 Dewatering 12 Other (Specify below) 2 Irrigation 4 Industrial 7 Domestic (lawn & garden) 10 Monitoring well LIVESTOCK Was a chemical/bacteriological sample submitted to Department? Yes No <input checked="" type="checkbox"/> ; If yes, mo/day/yr sample was submitted Water Well Disinfected? Yes <input checked="" type="checkbox"/> No

5 TYPE OF BLANK CASING USED: 1 Steel 3 RMP (SR) <u>2 PVC</u> 4 ABS	5 Wrought iron 8 Concrete tile 6 Asbestos-Cement 9 Other (specify below) 7 Fiberglass	CASING JOINTS: Glued <input checked="" type="checkbox"/> Clamped Welded Threaded
Blank casing diameter 5 in. to 4 1/4 ft., Dia Casing height above land surface 14 in., weight 160 lbs./ft. Wall thickness or guage No. SDR 26	TYPE OF SCREEN OR PERFORATION MATERIAL: 1 Steel 3 Stainless Steel 5 Fiberglass 8 RMP (SR) 2 Brass 4 Galvanized Steel 6 Concrete tile 9 ABS 11 Other (Specify) 12 None used (open hole)	
SCREEN OR PERFORATION OPENINGS ARE: 1 Continuous slot 3 Mill slot <u>•025</u> 2 Louvered shutter 4 Key punched	5 Guazed wrapped 8 Saw cut 6 Wire wrapped 9 Drilled holes 7 Torch cut 10 Other (specify) ft.	11 None (open hole)
SCREEN-PERFORATED INTERVALS: From 44 ft. to 64 ft., From ft. to ft. From ft. to ft., From ft. to ft.	GRAVEL PACK INTERVALS: From 25 ft. to 64 ft., From ft. to ft. From ft. to ft., From ft. to ft.	

6 GROUT MATERIAL: 1 Neat cement 2 Cement grout 3 Bentonite 4 Other
 Grout Intervals: From **0** ft. to **25** ft., From ft. to ft., From ft. to ft.
 What is the nearest source of possible contamination:
 1 Septic tank 4 Lateral lines 7 Pit privy 10 Livestock pens 14 Abandoned water well
 2 Sewer lines 5 Cess pool 8 Sewage lagoon 11 Fuel storage 15 Oil well/Gas well
 3 Watertight sewer lines 6 Seepage pit 9 Feedyard 12 Fertilizer storage 16 Other (specify below)
 13 Insecticide storage
 Direction from well? **NORTH** How many feet? **500**

FROM	TO	LITHOLOGIC LOG	FROM	TO	PLUGGING INTERVALS
0	2	TOP SOIL			
2	6	SANDY LOOM TAN			
6	13	CLAY TAN SILTY			
13	18	SAND AND BROWN DRIFT			
18	29	CLAY LIGHT GRAY			
29	62	SANDSTONE BROWN			
62	64	SHALE GRAY			

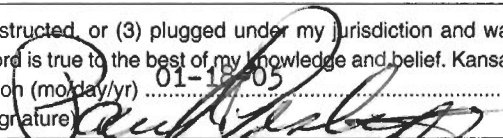7 CONTRACTOR'S OR LANDOWNER'S CERTIFICATION: This water well was (1) constructed, (2) reconstructed, or (3) plugged under my jurisdiction and was completed on (mo/day/year) **01-18-05** and this record is true to the best of my knowledge and belief. Kansas Water Well Contractor's Licence No **388** This Water Well Record was completed on (mo/day/yr) **01-18-05** under the business name of **PRSTINGER PUMP SERVICE** by (signature) 

INSTRUCTIONS: Use typewriter or ball point pen. PLEASE PRESS FIRMLY and PRINT clearly. Please fill in blanks, underline or circle the correct answers. Send top three copies to Kansas Department of Health and Environment, Bureau of Water, Geology Section, 1000 SW Jackson St., Suite 420, Topeka, Kansas 66612-1367. Telephone 785-296-5522. Send one to WATER WELL OWNER and retain one for your records. Fee of \$5.00 for each constructed well.