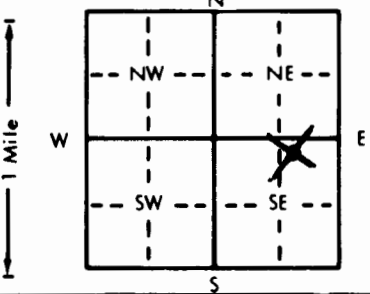


1 LOCATION OF WATER WELL: Fraction NW 1/4 NE 1/4 SE 1/4 Section Number 8 Township Number T 12 S Range Number R 5 W  
 County: Ottawa

Distance and direction from nearest town or city street address of well if located within city?

1 mile West & 1/2 mile North of Tescott

2 WATER WELL OWNER: Dean Larson  
 RR#, St. Address, Box #: Rt 1  
 City, State, ZIP Code: Tescott, KS 67484  
 Board of Agriculture, Division of Water Resources  
 Application Number:

3 LOCATE WELL'S LOCATION WITH AN "X" IN SECTION BOX:  4 DEPTH OF COMPLETED WELL: 85 ft. ELEVATION: ...  
 Depth(s) Groundwater Encountered 1. 29 ft. 2. ... ft. 3. ... ft.  
 WELL'S STATIC WATER LEVEL: 29 ft. below land surface measured on mo/day/yr 11-19-93  
 Pump test data: Well water was ... ft. after ... hours pumping ... gpm  
 Est. Yield 1.0-3.0 gpm: Well water was 58 ft. after 1 hours pumping 1.0 gpm  
 Bore Hole Diameter: 8 in. to 8.6 ft., and ... in. to ... ft.  
 WELL WATER TO BE USED AS:  
 5 Public water supply 8 Air conditioning 11 Injection well  
 1 Domestic 3 Feedlot 6 Oil field water supply 9 Dewatering 12 Other (Specify below)  
 2 Irrigation 4 Industrial 7 Lawn and garden only 10 Monitoring well Stock  
 Was a chemical/bacteriological sample submitted to Department? Yes ... No X ...; If yes, mo/day/yr sample was submitted  
 Water Well Disinfected? Yes X No

5 TYPE OF BLANK CASING USED:  
 1 Steel 3 RMP (SR) 5 Wrought iron 8 Concrete tile CASING JOINTS: Glued X Clamped  
 2 PVC 4 ABS 6 Asbestos-Cement 9 Other (specify below) Welded  
 7 Fiberglass Threaded  
 Blank casing diameter 5 in. to 6.5 ft., Dia. ... in. to ... ft., Dia. ... in. to ... ft.  
 Casing height above land surface 1.2 in., weight 2.37 lbs./ft. Wall thickness or gauge No. 214  
 TYPE OF SCREEN OR PERFORATION MATERIAL:  
 1 Steel 3 Stainless steel 5 Fiberglass 7 PVC 10 Asbestos-cement  
 2 Brass 4 Galvanized steel 6 Concrete tile 8 RMP (SR) 11 Other (specify)  
 12 None used (open hole)  
 SCREEN OR PERFORATION OPENINGS ARE:  
 1 Continuous slot 3 Mill slot 5 Gauzed wrapped 8 Saw cut 11 None (open hole)  
 2 Louvered shutter 4 Key punched 6 Wire wrapped 9 Drilled holes  
 7 Torch cut 10 Other (specify)  
 SCREEN-PERFORATED INTERVALS: From 65 ft. to 85 ft., From ... ft. to ... ft.  
 GRAVEL PACK INTERVALS: From 25 ft. to 85 ft., From ... ft. to ... ft.

6 GROUT MATERIAL: 1 Neat cement 2 Cement grout 3 Bentonite 4 Other  
 Grout Intervals: From 5 ft. to 25 ft., From ... ft. to ... ft., From ... ft. to ... ft.  
 What is the nearest source of possible contamination: None within 1/4 mile 10 Livestock pens 14 Abandoned water well  
 1 Septic tank 4 Lateral lines 7 Pit privy 11 Fuel storage 15 Oil well/Gas well  
 2 Sewer lines 5 Cess pool 8 Sewage lagoon 12 Fertilizer storage 16 Other (specify below)  
 3 Watertight sewer lines 6 Seepage pit 9 Feedyard 13 Insecticide storage

Direction from well? How many feet?

FROM	TO	LITHOLOGIC LOG	FROM	TO	PLUGGING INTERVALS
0	1	Sandy Top Soil			
1	11	Brown Clay			
11	12	Sandrock			
12	20	Gray Shale			
20	55	Shale & Sandstone layers			
55	75	Sandstone with shale layers			
75	76	Iron Pirite			
76	84	Sandstone			
84	86	Gray Shale			

7 CONTRACTOR'S OR LANDOWNER'S CERTIFICATION: This water well was (1) constructed, (2) reconstructed, or (3) plugged under my jurisdiction and was completed on (mo/day/year) 11-19-93 and this record is true to the best of my knowledge and belief. Kansas Water Well Contractor's License No. 138. This Water Well Record was completed on (mo/day/yr) 11-19-93 under the business name of Peterson Irrigation Inc. by (signature) Mike Peterson