


USE TYPEWRITER OR BALL
POINT PEN-PRESS FIRMLY,
PRINT CLEARLY.

WATER WELL RECORD
KSA 82a-1201-1215

Kansas Department of Health and
Environment-Division of Environment
(Water well Contractors)
Topeka, Kansas 66620

1. Location of well:		County Ottawa	Fraction 1/4 NE 1/4 NE 1/4	Section number 16	Township number T 12 S R 5	Range number 5
2. Distance and direction from nearest town or city: 330' N. of 2nd St. & 33' W. of Main Street Street address of well location if in city:				3. Owner of well: City of Tescott R.R. or street: Tescott, Ks. 67484 City, state, zip code:		
4. Locate with "X" in section below: N W E S 1 Mile		Sketch map: Well No. 5		6. Bore hole dia. 36 in. Completion date 9/30/77 Well depth 46 ft.		
		7. <input type="checkbox"/> Cable tool <input type="checkbox"/> Rotary <input type="checkbox"/> Driven <input type="checkbox"/> Dug <input type="checkbox"/> Hollow rod <input type="checkbox"/> Jetted <input type="checkbox"/> Bored <input checked="" type="checkbox"/> Reverse rotary				
		8. Use: <input type="checkbox"/> Domestic <input checked="" type="checkbox"/> Public supply <input type="checkbox"/> Industry <input type="checkbox"/> Irrigation <input type="checkbox"/> Air conditioning <input type="checkbox"/> Stock <input type="checkbox"/> Lawn <input type="checkbox"/> Oil field water <input type="checkbox"/> Other				
		9. Casing: Material Steel Height: Above ground 7 ft. <input checked="" type="checkbox"/> xxx Threaded <input type="checkbox"/> Welded <input checked="" type="checkbox"/> Surface 7 ft. <input checked="" type="checkbox"/> xxx RMP <input type="checkbox"/> PVC <input type="checkbox"/> Weight 34.24 lbs./ft. Dia. 10 in. to 36 ft. depth Wall Thickness: inches or Dia. 0.307 in. to 0 ft. depth gage No.				
		10. Screen: Manufacturer's name Layne & Bowler, Inc. Type Stainless Dia. 10" Slot/gauze 0.105" Length 10' Set between 36 ft. and 46 ft. Gravel pack? yes Size range of material 1/8x3/8				
5. Type and color of material		From	To	11. Static water level: 15.0 ft. below land surface Date 9/29/77 mo./day/yr.		
Top soil		0	2	12. Pumping level below land surfaces: 35.5 ft. after 4 1/2 hrs. pumping 125 g.p.m. ____ ft. after ____ hrs. pumping ____ g.p.m. Estimated maximum yield 125 g.p.m.		
Brown clay		2	11	13. Water sample submitted: X Yes <input type="checkbox"/> No Date ____ mo./day/yr.		
Brown clay & fine to silty sand		11	38	14. Well head completion: <input type="checkbox"/> Pitless adapter 7' In xxx above grade		
Med. to coarse sand & gravel & rock		38	46	15. Well grouted? yes With: <input type="checkbox"/> Neat cement <input type="checkbox"/> Bentonite <input checked="" type="checkbox"/> Concrete Depth: From 0 ft. to 20 ft.		
Blue-gray shale		46	49	16. Nearest source of possible contamination: Sewer Line ft. 220 Direction East Type Line Well disinfected upon completion? <input checked="" type="checkbox"/> Yes <input type="checkbox"/> No		
				17. Pump: Not installed Manufacturer's name Layne & Bowler Model number 8"PRHC HP 15 Volts 230 Length of drop pipe 40 ft. capacity 125 g.p.m. Type: <input type="checkbox"/> Submersible <input checked="" type="checkbox"/> Turbine <input type="checkbox"/> Jet <input type="checkbox"/> Reciprocating <input type="checkbox"/> Centrifugal <input type="checkbox"/> Other		
18. Elevation:				20. Water well contractor's certification: This well was drilled under my jurisdiction and this report is true to the best of my knowledge and belief. Layne Western Co. 102 Business name License No. Address Wichita, Kansas Signed Larry G. Kroll Date 10/31/77 Authorized representative		
19. Remarks: Topography: <input type="checkbox"/> Hill <input type="checkbox"/> Slope <input type="checkbox"/> Upland <input checked="" type="checkbox"/> Valley						

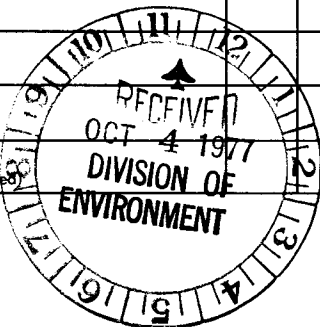

T 12 S R 5 NE 1/4 1/4 NE 1/4