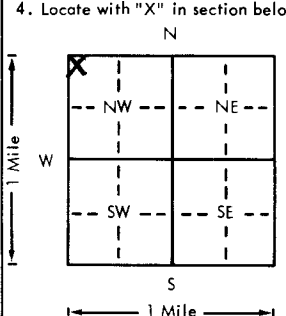
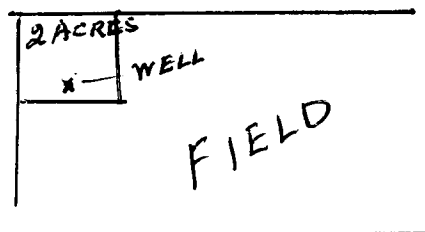


USE TYPEWRITER OR BALL POINT PEN-PRESS FIRMLY, PRINT CLEARLY.

WATER WELL RECORD
KSA 82a-1201-1215

Kansas Department of Health and Environment-Division of Environment
(Water well Contractors)
Topeka, Kansas 66620

1. Location of well:	County Ottawa	Fraction NW 1/4 NW 1/4 NW 1/4	Section number 27	Township number T 12 S R 5	Range number 5	E/W		
2. Distance and direction from nearest town or city: Street address of well location if in city: 1 mile south of Tescott			3. Owner of well: Mike Gotti R.R. or street: Tescott, Kansas City, state, zip code:					
4. Locate with "X" in section below: 			Sketch map: 			6. Bore hole dia. <u>8</u> in. Completion date _____ Well depth <u>43</u> ft. <u>11/14/77</u>		
5. Type and color of material			From		To			
			Clay		0		32	
			Sand		32		43	
							7. <input type="checkbox"/> Cable tool <input checked="" type="checkbox"/> Rotary <input type="checkbox"/> Driven <input type="checkbox"/> Dug <input type="checkbox"/> Hollow rod <input type="checkbox"/> Jetted <input type="checkbox"/> Bored <input type="checkbox"/> Reverse rotary	
							8. Use: <input checked="" type="checkbox"/> Domestic <input type="checkbox"/> Public supply <input type="checkbox"/> Industry <input type="checkbox"/> Irrigation <input type="checkbox"/> Air conditioning <input type="checkbox"/> Stock <input type="checkbox"/> Lawn <input type="checkbox"/> Oil field water <input type="checkbox"/> Other	
							9. Casing: Material <u>plst</u> Height: Above or below Threaded _____ Welded <u>gl</u> Surface <u>18</u> in. RMP <input checked="" type="checkbox"/> PVC _____ Weight _____ lbs./ft. Dia. <u>5</u> in. to <u>43</u> ft. depth; Wall Thickness: inches or Dia. _____ in. to _____ ft. depth; gage No. <u>0.258</u>	
							10. Screen: Manufacturer's name _____ <u>Western Plastics</u> Type <u>RIP</u> Dia. <u>5"</u> Slot/gauze <u>3/32</u> Length <u>6'</u> Set between <u>37</u> ft. and <u>43</u> ft. _____ ft. and _____ ft. Gravel pack? <u>Yes</u> Size range of material <u>1/16 to 3/8</u>	
							11. Static water level: _____ mo./day/yr. <u>4</u> ft. below land surface Date <u>11/14/77</u>	
							12. Pumping level below land surfaces: _____ ft. after _____ hrs. pumping _____ g.p.m. _____ ft. after _____ hrs. pumping _____ g.p.m. Estimated maximum yield <u>30+</u> g.p.m.	
							13. Water sample submitted: _____ mo./day/yr. <input type="checkbox"/> Yes <input checked="" type="checkbox"/> No Date _____	
							14. Well head completion: <input type="checkbox"/> Pitless adapter _____ <u>18</u> Inches above grade	
							15. Well grouted? <u>Yes</u> With: <input checked="" type="checkbox"/> Neat cement <input type="checkbox"/> Bentonite <input type="checkbox"/> Concrete Depth: From <u>0</u> ft. to <u>10</u> ft.	
							16. Nearest source of possible contamination: ft. _____ Direction _____ Type <u>none</u> Well disinfected upon completion? <input checked="" type="checkbox"/> Yes <input type="checkbox"/> No	
							17. Pump: <input checked="" type="checkbox"/> Not installed Manufacturer's name _____ Model number _____ HP _____ Volts _____ Length of drop pipe _____ ft. capacity _____ g.p.m. Type: <input type="checkbox"/> Submersible <input type="checkbox"/> Turbine <input type="checkbox"/> Jet <input type="checkbox"/> Reciprocating <input type="checkbox"/> Centrifugal <input type="checkbox"/> Other	
							(Use a second sheet if needed)	
18. Elevation: Topography: <input type="checkbox"/> Hill <input type="checkbox"/> Slope <input type="checkbox"/> Upland <input checked="" type="checkbox"/> Valley		19. Remarks:		20. Water well contractor's certification: This well was drilled under my jurisdiction and this report is true to the best of my knowledge and belief. <u>Rader Drilling Co.</u> 194 Business name License No. Address <u>Carlton, Kansas 67429</u> Signed <u>Brant E Rader</u> Date <u>8-10-78</u> Authorized representative				

T 12 S R 5 W E 27 NW 1/4 NW 1/4 NW 1/4

Forward the white, blue and pink copies to the Department of Health and Environment

Form WWC-5