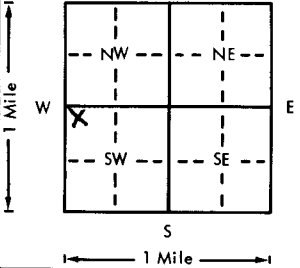


21-77

USE TYPEWRITER OR BALL POINT PEN-PRESS FIRMLY, PRINT CLEARLY.

WATER WELL RECORD
KSA 82a-1201-1215

Kansas Department of Health and Environment-Division of Environment
(Water well Contractors)
Topeka, Kansas 66620

1. Location of well: County OTTOWA Fraction NW¹/₄ NW¹/₄ SW¹/₄ Section number 32 Township number T 12 S R 5 E/W Range number	
2. Distance and direction from nearest town or city: 4 S - 2 W Street address of well location if in city: of TES COTT	
3. Owner of well: HYDROCARBON TRANSPORTATION Co R.R. street: #1 BOX 5L City, state, zip code: BUSHTON, KANSAS 67427	
4. Locate with "X" in section below: Sketch map: 	
5. Type and color of material	
	From To
TOPSOIL	0 2
SANDY CLAY	2 4
SAND	4 7
SANDROCK	7 47
GRAY CLAY	47 48
STOP	48
(Use a second sheet if needed)	
18. Elevation: ~1200' Topography: <input type="checkbox"/> Hill <input type="checkbox"/> Slope <input checked="" type="checkbox"/> Upland <input type="checkbox"/> Valley	19. Remarks:
6. Bore hole dia. 8 in. Completion date 4/29/77 Well depth 47 ft.	
7. <input checked="" type="checkbox"/> Cable tool <input checked="" type="checkbox"/> Rotary <input type="checkbox"/> Driven <input type="checkbox"/> Dug <input type="checkbox"/> Hollow rod <input type="checkbox"/> Jetted <input type="checkbox"/> Bored <input type="checkbox"/> Reverse rotary	
8. Use: <input checked="" type="checkbox"/> Domestic <input type="checkbox"/> Public supply <input type="checkbox"/> Industry <input type="checkbox"/> Irrigation <input type="checkbox"/> Air conditioning <input type="checkbox"/> Stock <input type="checkbox"/> Lawn <input type="checkbox"/> Oil field water <input type="checkbox"/> Other	
9. Casing: Material PVC Height: Above or below <input checked="" type="checkbox"/> Threading: <input type="checkbox"/> Welded <input checked="" type="checkbox"/> Surface 18 in. RMP: <input type="checkbox"/> PVC <input checked="" type="checkbox"/> Weight 3 lbs./ft. Dia. 5 in. to 47 ft. depth Wall Thickness: inches or Dia. <input type="checkbox"/> in. to <input type="checkbox"/> ft. depth gage No. 1258	
10. Screen: Manufacturer's name PUMPCO (MPI) Type PVC Dia. 5 Slot/gauze 1/16 Length 10 Set between 3 1/2 ft. and 4 1/2 ft. Gravel pack? YES Size range of material 48x44	
11. Static water level: 4 ft. below land surface Date 4-29-77 mo./day/yr.	
12. Pumping level below land surfaces: <input type="checkbox"/> ft. after <input type="checkbox"/> hrs. pumping <input type="checkbox"/> g.p.m. <input type="checkbox"/> ft. after <input type="checkbox"/> hrs. pumping <input type="checkbox"/> g.p.m. Estimated maximum yield 50 g.p.m.	
13. Water sample submitted: <input type="checkbox"/> Yes <input checked="" type="checkbox"/> No Date	
14. Well head completion: <input type="checkbox"/> Pitless adapter 18 inches above grade	
15. Well grouted? YES With: <input checked="" type="checkbox"/> Neat cement <input type="checkbox"/> Bentonite <input type="checkbox"/> Concrete Depth: From 0 ft. to 10 ft.	
16. Nearest source of possible contamination: SEPTIC TANK ft. 3/4 MILE Direction NORTH Type TANK Well disinfected upon completion? <input checked="" type="checkbox"/> Yes <input type="checkbox"/> No	
17. Pump: <input checked="" type="checkbox"/> Not installed Manufacturer's name JACUZZI Model number 554B HP 1/2 Volts 230 Length of drop pipe 30 ft. capacity 10 g.p.m. Type: <input checked="" type="checkbox"/> Submersible <input type="checkbox"/> Turbine <input type="checkbox"/> Jet <input type="checkbox"/> Reciprocating <input type="checkbox"/> Centrifugal <input type="checkbox"/> Other	
20. Water well contractor's certification: This well was drilled under my jurisdiction and this report is true to the best of my knowledge and belief. Geo Cox + Sons Inc. 258 Business name License No. Address CLIFTON KANS 66937 Signed Daryl Cox Date 5-24-77 Authorized representative	

L
2
-
5
m
3
2
NW
NW
SW
1/4
1/4
1/4
1/4

Forward the white, blue and pink copies to the Department of Health and Environment

Form WWC-5