


1 LOCATION OF WATER WELL: County: <u>Lincoln</u>	Fraction C <u>1/4</u> SW <u>1/4</u> <u>1/4</u>	Section Number <u>7</u>	Township Number T <u>12</u> S	Range Number R <u>6W</u> E/W
---	---	----------------------------	----------------------------------	---------------------------------

Distance and direction from nearest town or city street address of well if located within city?

1/2 W of Shady Bend, Kansas

2 WATER WELL OWNER: John Thomsen
 RR#, St. Address, Box # : Route 1
 City, State, ZIP Code : Lincoln, Kansas 67455
 Board of Agriculture, Division of Water Resources
 Application Number: _____

3 LOCATE WELL'S LOCATION WITH AN "X" IN SECTION BOX:

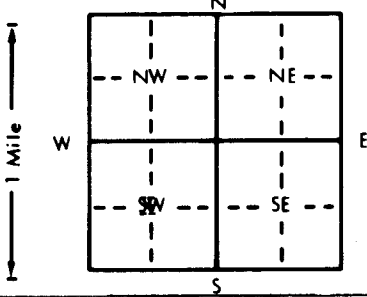

4 DEPTH OF COMPLETED WELL. 170 ft. ELEVATION: Unknown

Depth(s) Groundwater Encountered 1. 90 ft. 2. _____ ft. 3. _____ ft.
 WELL'S STATIC WATER LEVEL 90 ft. below land surface measured on mo/day/yr 8/14/91
 Pump test data: Well water was _____ ft. after _____ hours pumping _____ gpm
 Est. Yield _____ gpm: Well water was _____ ft. after _____ hours pumping _____ gpm
 Bore Hole Diameter: 8 in. to 170 ft., and _____ in. to _____ ft.

WELL WATER TO BE USED AS:
 1 Domestic 3 Feedlot 6 Oil field water supply 9 Dewatering 11 Injection well
 2 Irrigation 4 Industrial 7 Lawn and garden only 10 Monitoring well
 5 Public water supply 8 Air conditioning
 12 Other (Specify below)
 Was a chemical/bacteriological sample submitted to Department? Yes _____ No _____
 Water Well Disinfected? Yes _____ No _____

5 TYPE OF BLANK CASING USED:

1 <u>Steel</u>	3 <u>RMP (SR)</u>	5 <u>Wrought iron</u>	8 <u>Concrete tile</u>	CASING JOINTS: <u>Glued</u> Clamped _____
2 <u>PVC</u>	4 <u>ABS</u>	6 <u>Asbestos-Cement</u>	9 <u>Other (specify below)</u>	Welded _____
Blank casing diameter _____ in. to <u>150</u> ft., Dia _____ in. to _____ ft., Dia _____ in. to _____ ft.		7 <u>Fiberglass</u>	Threaded _____	
Casing height above land surface _____ in., weight _____ lbs./ft. Wall thickness or gauge No. <u>Sch. 40</u>				

TYPE OF SCREEN OR PERFORATION MATERIAL:

1 <u>Steel</u>	3 <u>Stainless steel</u>	5 <u>Fiberglass</u>	8 <u>RMP (SR)</u>	10 <u>Asbestos-cement</u>
2 <u>Brass</u>	4 <u>Galvanized steel</u>	6 <u>Concrete tile</u>	9 <u>ABS</u>	11 <u>Other (specify)</u> _____
12 <u>None used (open hole)</u>				

SCREEN OR PERFORATION OPENINGS ARE:

1 <u>Continuous slot</u>	3 <u>Mill slot</u>	5 <u>Gauzed wrapped</u>	8 <u>Saw cut</u>	11 <u>None (open hole)</u>
2 <u>Louvered shutter</u>	4 <u>Key punched</u>	6 <u>Wire wrapped</u>	9 <u>Drilled holes</u>	
7 <u>Torch cut</u> 10 <u>Other (specify)</u> _____				

SCREEN-PERFORATED INTERVALS: From _____ ft. to _____ ft., From _____ ft. to _____ ft., From _____ ft. to _____ ft.

GRAVEL PACK INTERVALS: From _____ ft. to _____ ft., From _____ ft. to _____ ft., From _____ ft. to _____ ft.

6 GROUT MATERIAL: 1 Neat cement 2 Cement grout 3 Bentonite 4 Other _____

Grout Intervals: From _____ ft. to _____ ft., From _____ ft. to _____ ft., From _____ ft. to _____ ft.

What is the nearest source of possible contamination:

1 <u>Septic tank</u>	4 <u>Lateral lines</u>	7 <u>Pit privy</u>	10 <u>Livestock pens</u>	14 <u>Abandoned water well</u>
2 <u>Sewer lines</u>	5 <u>Cess pool</u>	8 <u>Sewage lagoon</u>	11 <u>Fuel storage</u>	15 <u>Oil well/Gas well</u>
3 <u>Watertight sewer lines</u>	6 <u>Seepage pit</u>	9 <u>Feedyard</u>	12 <u>Fertilizer storage</u>	16 <u>Other (specify below)</u>
			13 <u>Insecticide storage</u>	<u>In pasture</u>

Direction from well? _____ How many feet? _____

FROM	TO	LITHOLOGIC LOG	FROM	TO	PLUGGING INTERVALS
0	45	Clay			
45	110	Shale			
110	170	Sand rock			

7 CONTRACTOR'S OR LANDOWNER'S CERTIFICATION: This water well was (1) constructed, (2) reconstructed, or (3) plugged under my jurisdiction and was completed on (mo/day/year) .. 8/14/91 and this record is true to the best of my knowledge and belief. Kansas Water Well Contractor's License No.186 This Water Well Record was completed on (mo/day/yr)9/30/91 under the business name of Kelly's Water Well Service by (signature) _____