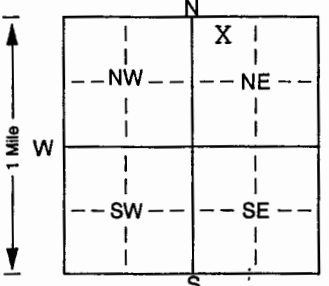


1 LOCATION OF WATER WELL: County: Lincoln	Fraction NW ¼ NW ¼ NE ¼	Section Number 36	Township Number T 12 S	Range Number R 6 EW
---	----------------------------	-----------------------------	---------------------------	------------------------

Distance and direction from nearest town or city street address of well if located within city?
4 mi. E and 3 mi. N of Westfall

2 WATER WELL OWNER: **R & L Farms**
 RR#, St. Address, Box # : **3065 N. College PMB 146**
 City, State, ZIP Code : **Fayetteville, Arkansas**
 Board of Agriculture, Division of Water Resources
 Application Number:

3 LOCATE WELL'S LOCATION WITH AN "X" IN SECTION BOX:

 4 DEPTH OF COMPLETED WELL: **100** ft. ELEVATION:
 Depth(s) Groundwater Encountered 1. **50** ft. 2. ft. 3. ft.
 WELL'S STATIC WATER LEVEL: **49.6** ft. below land surface measured on mo/day/yr **7/30/2007**
 Pump test data: Well water was ft. after hours pumping gpm
 Est. Yield **20+** gpm: Well water was ft. after hours pumping gpm
 Bore Hole Diameter: **10** in. to **10** ft., and **8** in. to **10** ft.
 WELL WATER TO BE USED AS:
 5 Public water supply 8 Air conditioning 11 Injection well
 1 Domestic 3 Feedlot 6 Oil field water supply 9 Dewatering 12 Other (Specify below)
 2 Irrigation 4 Industrial 7 Domestic (lawn & garden) 10 Monitoring well **Livestock**
 Was a chemical/bacteriological sample submitted to Department? Yes. No. ; If yes, mo/day/yr sample was submitted
 Water Well Disinfected? Yes No

5 TYPE OF BLANK CASING USED:
 1 Steel 2 RMP (SR) 3 ABS 4 PVC 5 Wrought iron 6 Asbestos-Cement 7 Fiberglass 8 Concrete tile 9 Other (specify below) CASING JOINTS: Glued Clamped
 10 Asbestos-cement 11 Other (specify)
 12 None used (open hole)
 Blank casing diameter 5 in. to 60 ft., Dia in. to ft., Dia in. to ft.
 Casing height above land surface: **18** in., weight **160** lbs./ft. Wall thickness or gauge No.
 TYPE OF SCREEN OR PERFORATION MATERIAL:
 1 Steel 2 Brass 3 Stainless steel 4 Galvanized steel 5 Fiberglass 6 Concrete tile 7 PVC 8 RMP (SR) 9 ABS 10 Asbestos-cement 11 Other (specify)
 12 None used (open hole)
 SCREEN OR PERFORATION OPENINGS ARE:
 1 Continuous slot 2 Louvered shutter 3 Mill slot 4 Key punched 5 Gauzed wrapped 6 Wire wrapped 7 Torch cut 8 Saw cut 9 Drilled holes 10 Other (specify) ft.
 11 None (open hole)
 SCREEN-PERFORATED INTERVALS: From: **60** ft. to **100** ft., From ft. to ft.
 GRAVEL PACK INTERVALS: From: **20** ft. to **100** ft., From ft. to ft.

6 GROUT MATERIAL: 1 Neat cement 2 Cement grout 3 Bentonite 4 Other
 Grout Intervals: From ft. to ft., From ft. to ft.
 What is the nearest source of possible contamination:
 1 Septic tank 2 Sewer lines 3 Watertight sewer lines 4 Lateral lines 5 Cess pool 6 Seepage pit 7 Pit privy 8 Sewage lagoon 9 Feedyard 10 Livestock pens 11 Fuel storage 12 Fertilizer storage 13 Insecticide storage 14 Abandoned water well 15 Oil well/Gas well 16 Other (specify below)
 Direction from well? **In Pasture**
 How many feet?

FROM	TO	LITHOLOGIC LOG	FROM	TO	PLUGGING INTERVALS
0	2	Clay			
2	58	Sandstone			
58	60	Shale - gray			
60	65	Sandstone and shale			
65	75	Sandstone			
75	80	Shale with sandstone lenses			
80	100	Sandstone			

7 CONTRACTOR'S OR LANDOWNER'S CERTIFICATION: This water well was **(1)** constructed, (2) reconstructed, or (3) plugged under my jurisdiction and was completed on (mo/day/year) **7/30/2007** and this record is true to the best of my knowledge and belief. Kansas Water Well Contractor's Licence No. **727** This Water Well Record was completed on (mo/day/yr) **8/24/2007** under the business name of **GeoCore Inc.** by (signature) **Joe Bell**