

MW-7

WATER WELL RECORD

Form WWC-5

Division of Water Resources App. No.


Empty box for application number

1 LOCATION OF WATER WELL: County: Lincoln, Fraction: 1/4 NE 1/4 SW 1/4 NE 1/4, Section Number: 15, Township No.: T 12 S, Range Number: R 6, E, W

Street/Rural Address of Well Location; if unknown, distance & direction from nearest town or intersection: Southeast of the intersection of E. Railroad Ave. & Main St., Beverly, KS

Global Positioning System (GPS) information: Latitude: 39.0124, Longitude: 97.97336, Elevation: , Datum: WGS 84, Collection Method: GPS unit (Make/Model: Garmin 60C)

2 WATER WELL OWNER: Koch Remediation & Env. Services, RR#, Street Address, Box #: 4111 East 37th St. North, City, State, ZIP Code: Wichita, KS 67220

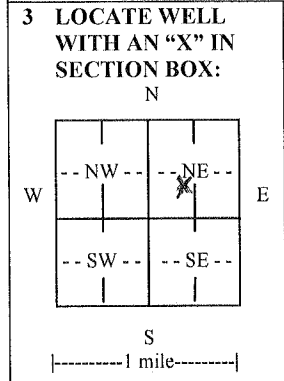

3 LOCATE WELL WITH AN "X" IN SECTION BOX: 4 DEPTH OF COMPLETED WELL 38 ft. Depth(s) Groundwater Encountered (1) 25 ft. (2) ft. (3) ft. WELL'S STATIC WATER LEVEL 23.26 ft. below land surface measured on mo/day/yr. 

5 TYPE OF CASING USED: PVC, CASING JOINTS: Threaded, Casing diameter 2 in. to 28 ft., Casing height above land surface Flush, TYPE OF SCREEN OR PERFORATION MATERIAL: PVC, SCREEN OR PERFORATION OPENINGS ARE: Mill slot, SCREEN-PERFORATED INTERVALS: From 38 ft. to 28 ft., GRAVEL PACK INTERVALS: From 38 ft. to 26 ft.

6 GROUT MATERIAL: Bentonite, Grout Intervals: From 26 ft. to 2 ft., What is the nearest source of possible contamination: Fuel storage

Table with columns: FROM, TO, LITHOLOGIC LOG, FROM, TO, LITHO. LOG (cont.) or PLUGGING INTERVALS. Row 1: 0 to 32, Silty Clay. Row 2: 32 to 38, Silty Clay w/very fine sand.

7 CONTRACTOR'S OR LANDOWNER'S CERTIFICATION: This water well was constructed, reconstructed, or plugged under my jurisdiction and was completed on (mo/day/year) 9/8/2014 and this record is true to the best of my knowledge and belief. Kansas Water Well Contractor's License No. 7.10. This Water Well Record was completed on (mo/day/year) 9/24/2014 under the business name of Below Ground Surface, Inc. by (signature) [Signature]

INSTRUCTIONS: Use typewriter or ball point pen. PLEASE PRESS FIRMLY and PRINT clearly. Please fill in blanks and check the correct answers. Send three copies (white, blue, pink) to Kansas Department of Health and Environment, Bureau of Water, Geology Section, 1000 SW Jackson St., Suite 420, Topeka, Kansas 66612-1367. Telephone 785-296-5524. Send one copy to WATER WELL OWNER and retain one for your records. Include fee of \$5.00 for each constructed well. Visit us at http://www.kdheks.gov/waterwell/index.html.