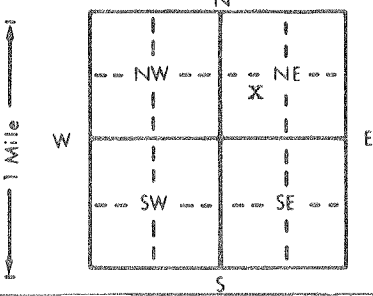


1 LOCATION OF WATER WELL: Fraction NE 1/4 SW 1/4 NE 1/4 Section Number 15 Township Number T 12 S Range Number R 6 E/W
 County: LINCOLN

Distance and direction from nearest town or city street address of well if located within city?
 BEVERLY, KS.

2 WATER WELL OWNER: CLAYTON DEWHIRST
 RR#, St. Address, Box #: P.O. BOX 131 Board of Agriculture, Division of Water Resources
 City, State, ZIP Code: BEVERLY, KS. 67423 Application Number:

3 LOCATE WELL'S LOCATION WITH AN "X" IN SECTION BOX:

 4 DEPTH OF COMPLETED WELL: 50.8 ft. ELEVATION:
 Depth(s) Groundwater Encountered 1. 18.4 ft. 2. ft. 3. ft.
 WELL'S STATIC WATER LEVEL: 18.4 ft. below land surface measured on mo/day/yr 10-19-94
 Pump test data: Well water was 28.8 ft. after 1 hours pumping 30 gpm
 Est. Yield: 7.5 gpm: Well water was ft. after hours pumping gpm
 Bore Hole Diameter: 9 in. to 51 ft., and in. to ft.
 WELL WATER TO BE USED AS:
 5 Public water supply 8 Air conditioning 11 Injection well
 1 Domestic 3 Feedlot 6 Oil field water supply 9 Dewatering 12 Other (Specify below)
 2 Irrigation 4 Industrial 7 Lawn and garden only 10 Monitoring well
 Was a chemical/bacteriological sample submitted to Department? Yes No X If yes, mo/day/yr sample was submitted
 Water Well Disinfected? Yes X No

5 TYPE OF BLANK CASING USED:
 1 Steel 3 RMP (SR) 5 Wrought iron 8 Concrete tile CASING JOINTS: Glued X Clamped
 2 PVC 4 ABS 6 Asbestos-Cement 9 Other (specify below) Welded
 7 Fiberglass Threaded
 Blank casing diameter: 5 in. to 40.8 ft., Dia. in. to ft., Dia. in. to ft.
 Casing height above land surface: 18 in., weight 160 lbs./ft. Wall thickness or gauge No. SDR 26
 TYPE OF SCREEN OR PERFORATION MATERIAL:
 1 Steel 3 Stainless steel 5 Fiberglass 8 RMP (SR) 10 Asbestos-cement
 2 Brass 4 Galvanized steel 6 Concrete tile 9 ABS 11 Other (specify)
 12 None used (open hole)
 SCREEN OR PERFORATION OPENINGS ARE:
 1 Continuous slot 3 Mill slot .035 5 Gauzed wrapped 8 Saw cut 11 None (open hole)
 2 Louvered shutter 4 Key punched 6 Wire wrapped 9 Drilled holes
 7 Torch cut 10 Other (specify)
 SCREEN-PERFORATED INTERVALS: From 40.8 ft. to 50.8 ft., From ft. to ft.
 GRAVEL PACK INTERVALS: From 22 ft. to 50.8 ft., From ft. to ft.

6 GROUT MATERIAL: 1 Neat cement 2 Cement grout 3 Bentonite 4 Other
 Grout Intervals: From 0 ft. to 22 ft., From ft. to ft., From ft. to ft.
 What is the nearest source of possible contamination:
 1 Septic tank 4 Lateral lines 7 Pit privy 10 Livestock pens 14 Abandoned water well
 2 Sewer lines 5 Cess pool 8 Sewage lagoon 11 Fuel storage 15 Oil well/Gas well
 3 Watertight sewer lines 6 Seepage pit 9 Feedyard 12 Fertilizer storage 16 Other (specify below)
 13 Insecticide storage
 Direction from well? EAST How many feet? 35

FROM	TO	LITHOLOGIC LOG	FROM	TO	PLUGGING INTERVALS
0	4	FILL DIRT			
4	14	CLAY SOFT SILTY BROWN			
14	38	CLAY SOFT TAN WITH GRAY LAYERS			
38	50.8	SANDSTONE SOFT FINE GRAIN TAN			

7 CONTRACTOR'S OR LANDOWNER'S CERTIFICATION: This water well was (1) constructed, (2) reconstructed, or (3) plugged under my jurisdiction and was completed on (mo/day/year) 10-19-94 and this record is true to the best of my knowledge and belief. Kansas
 Water Well Contractor's License No. 388 This Water Well Record was completed on (mo/day/year) 10-19-94
 under the business name of PESTINGER PUMP SERVICE by (signature)