


1 LOCATION OF WATER WELL: County: LINCOLN 053 Fraction SE 1/4 SE 1/4 NW 1/4 Section Number 6 Township Number T 12 S Range Number R 7 EW

Distance and direction from nearest town or city street address of well if located within city?  
120 W. YAUGER

2 WATER WELL OWNER: CHARLES GRAMB RR#, St. Address, Box #: 120 W. YAUGER City, State, ZIP Code: LINCOLN, KS. 67455 Board of Agriculture, Division of Water Resources Application Number:

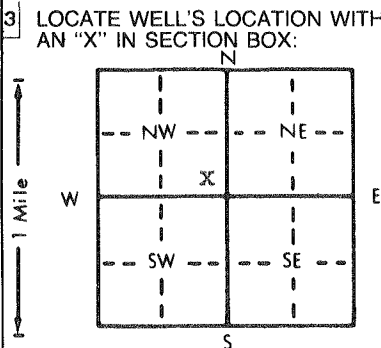

4 DEPTH OF COMPLETED WELL: 63 ft. ELEVATION: 34.2 ft. below land surface measured on 8-18-95. WELL'S STATIC WATER LEVEL: 34.2 ft. below land surface measured on 8-18-95. Pump test data: Well water was 41.6 ft. after 1 hours pumping 30 gpm. Est. Yield 75 gpm: Well water was ft. after hours pumping gpm. Bore Hole Diameter 9 in. to 64 ft., and in. to ft. WELL WATER TO BE USED AS: 5 Public water supply 8 Air conditioning 11 Injection well 1 Domestic 3 Feedlot 6 Oil field water supply 9 Dewatering 12 Other (Specify below) 2 Irrigation 4 Industrial 7 Lawn and garden 10 Monitoring well. Was a chemical/bacteriological sample submitted to Department? Yes No X; If yes, mo/day/yr sample was submitted Water Well Disinfected? Yes X No

5 TYPE OF BLANK CASING USED: 1 Steel 3 RMP (SR) 5 Wrought iron 8 Concrete tile CASING JOINTS: Glued X Clamped Welded Threaded. 2 PVC 4 ABS 6 Asbestos-Cement 9 Other (specify below) 7 Fiberglass. Blank casing diameter 5 in. to 53 ft., Dia. 16 in. to 160 lbs./ft. Wall thickness or gauge No. SDR 26. TYPE OF SCREEN OR PERFORATION MATERIAL: 1 Steel 3 Stainless steel 5 Fiberglass 8 RMP (SR) 10 Asbestos-cement 2 Brass 4 Galvanized steel 6 Concrete tile 9 ABS 11 Other (specify) 12 None used (open hole). SCREEN OR PERFORATION OPENINGS ARE: 1 Continuous slot 3 Mill slot .035 6 Wire wrapped 9 Drilled holes 2 Louvered shutter 4 Key punched 7 Torch cut 10 Other (specify). SCREEN-PERFORATED INTERVALS: From 53 ft. to 63 ft., From ft. to ft. GRAVEL PACK INTERVALS: From 43 ft. to 63 ft., From ft. to ft.

6 GROUT MATERIAL: 1 Neat cement 2 Cement grout 3 Bentonite 4 Other. Grout Intervals: From 0 ft. to 25 ft., From ft. to ft., From ft. to ft. What is the nearest source of possible contamination: 1 Septic tank 4 Lateral lines 7 Pit privy 10 Livestock pens 14 Abandoned water well 2 Sewer lines 5 Cess pool 8 Sewage lagoon 11 Fuel storage 15 Oil well/Gas well 3 Watertight sewer lines 6 Seepage pit 9 Feedyard 12 Fertilizer storage 16 Other (specify below) 13 Insecticide storage. Direction from well? NORTH How many feet? 20

FROM	TO	LITHOLOGIC LOG	FROM	TO	PLUGGING INTERVALS
0	3	FILL DIRT			
3	17	CLAY RED			
17	35	CLAY WHITE			
35	63	SANDSTONE TAN			

7 CONTRACTOR'S OR LANDOWNER'S CERTIFICATION: This water well was (1) constructed, (2) reconstructed, or (3) plugged under my jurisdiction and was completed on (mo/day/year) 8-18-95 and this record is true to the best of my knowledge and belief. Kansas Water Well Contractor's License No. 388 This Water Well Record was completed on (mo/day/yr) 8-18-95 under the business name of PESTINGER PUMP SERVICE by (signature) [Signature]

INSTRUCTIONS: Use typewriter or ball point pen. PLEASE PRESS FIRMLY and PRINT clearly. Please fill in blanks, underline or circle the correct answers. Send top three copies to Kansas Department of Health and Environment, Bureau of Water, Topeka, Kansas 66620-0001. Telephone: 913-296-5545. Send one to WATER WELL OWNER and retain one for your records.