


1 LOCATION OF WATER WELL: County: **Saline** Fraction: **SE 1/4 NE 1/4 SE 1/4** Section Number: **13** Township Number: **T 13 S** Range Number: **R 1 E/W**

Distance and direction from nearest town or city street address of well if located within city?
201 W. 4th St., Solomon

2 WATER WELL OWNER: **KDHE**
 RR#, St. Address, Box #: **1000 SW Jackson, Suite 410** Board of Agriculture, Division of Water Resources
 City, State, ZIP Code: **Topeka, Kansas 66612-1367** Application Number:

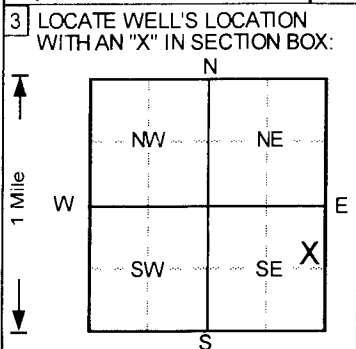

4 DEPTH OF COMPLETED WELL: **30** ft. ELEVATION: **1169.65**
 Depth(s) Groundwater Encountered 1. ft. 2. ft. 3. ft.
 WELL'S STATIC WATER LEVEL ft. below land surface measured on mo/day/yr
 Pump test data: Well water was **NA** ft. after hours pumping gpm
 Est. Yield **NA** gpm Well water was ft. after hours pumping gpm
 Bore Hole Diameter **60** in. to **30** ft. and in. to ft.
 WELL WATER TO BE USED AS: 5 Public water supply 8 Air conditioning 11 Injection well
 1 Domestic 3 Feedlot 6 Oil field water supply 9 Dewatering **12** Other (Specify below)
 2 Irrigation 4 Industrial 7 Lawn and garden only 10 Monitoring well **Air sparge, SVE**
 Was a chemical/bacteriological sample submitted to Department? Yes.....No ; If yes, mo/day/yr sample was submitted
 Water Well Disinfected? Yes No

5 TYPE OF BLANK CASING USED: 1 Steel 2 **PVC** 3 RMP (SR) 4 ABS 5 Wrought iron 6 Asbestos-Cement 7 Fiberglass 8 Concrete tile 9 Other (specify below) CASING JOINTS: Glued Clamped Welded Threaded
 Blank casing diameter **2 (4)** in. to **28(10)** ft. Dia in. to ft. Dia in. to ft.
 Casing height above land surface **-0.36** in., weight lbs./ft. Wall thickness or gauge No. **Sch. 40**
 TYPE OF SCREEN OR PERFORATION MATERIAL: 1 Steel 2 Brass 3 Stainless steel 4 Galvanized steel 5 Fiberglass 6 Concrete tile 7 **PVC** 8 RMP (SR) 9 ABS 10 Asbestos-cement 11 Other (specify) 12 None used (open hole)
 SCREEN OR PERFORATION OPENINGS ARE: 1 Continuous slot 2 Louvered shutter 3 **Mill slot** 4 Key punched 5 Gauzed wrapped 6 Wire wrapped 7 Torch cut 8 Saw cut 9 Drilled holes 10 Other (specify) 11 None (open hole)
 SCREEN-PERFORATED INTERVALS: From **28 (10)** ft. to **30(20)** ft. From ft. to ft.
 GRAVEL PACK INTERVALS: From **0** ft. to **1 (rock)**ft. From **1** ft. to **5** ft.
 From **8** ft. to **30** ft. From ft. to ft.

6 GROUT MATERIAL: 1 Neat cement 2 Cement grout 3 Bentonite 4 **Other Concrete**
 Grout Intervals: From **5** ft. to **8** ft. From ft. to ft. From ft. to ft.
 What is the nearest source of possible contamination:
 1 Septic tank 2 Sewer lines 3 Watertight sewer lines 4 Lateral lines 5 Cess pool 6 Seepage pit 7 Pit privy 8 Sewage lagoon 9 Feedyard 10 Livestock pens 11 Fuel storage 12 Fertilizer storage 13 Insecticide storage 14 Abandoned water well 15 Oil well/Gas well **16 Other (specify below)**
Abdn fuel storage
 Direction from well? How many feet?

FROM	TO	LITHOLOGIC LOG	FROM	TO	PLUGGING INTERVALS
0	0.5	Concrete,			
0.5	1	Rubble fill,			
1	6	Clay, silty, Black			Nested wells in same large diameter boring.
6	9	Silt, clayey, Med. Gray			
9	12	Silt, sl. clayey, Lt. Gray			
12	20	Silt, Lt. Gray			
20	22	Silt, sl. clayey to sandy, Lt. Gray			
22	25	Sand, v. silty, Lt. Gray			
25	30	Sand, vc to gravel, Lt. Gray			
					AS5 and SVE5

7 CONTRACTOR'S OR LANDOWNER'S CERTIFICATION: This water well was **(1)** constructed, (2) reconstructed, or (3) plugged under my jurisdiction and was completed on (mo/day/year) **7/1/2011** and this record is true to the best of my knowledge and belief.
 Kansas Water Well Contractor's License No. **527** This Water Well Record was completed on (mo/day/yr) **7/25/11** under the business name of **GeoCore, Inc.** by (signature) *Debra Reed*

INSTRUCTIONS: Use typewriter or ball point pen. PLEASE PRESS FIRMLY and PRINT clearly. Please fill in blanks, underline or circle the correct answers. Send top three copies to Kansas Department of Health and Environment, Bureau of Water, Topeka, Kansas 66620-0001. Telephone: 913-296-5545. Send one to WATER WELL OWNER and retain one for your records.

OFFICE USE ONLY
T
R
SEC.
1/4
1/4
1/4