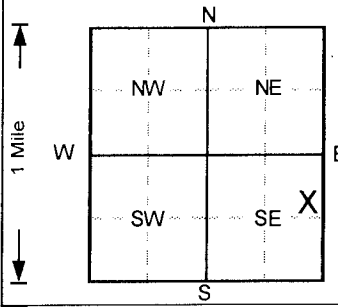


1 LOCATION OF WATER WELL: County: <b>Saline</b>	Fraction <b>SE ¼ NE ¼ SE ¼</b>	Section Number <b>13</b>	Township Number <b>T 13 S</b>	Range Number <b>R 1 E/W</b>
--	-----------------------------------	-----------------------------	----------------------------------	--------------------------------

Distance and direction from nearest town or city street address of well if located within city?  
**201 W. 4th St., Solomon**

2 WATER WELL OWNER: **KDHE**  
 RR#, St. Address, Box # : **1000 SW Jackson, Suite 410**  
 City, State, ZIP Code : **Topeka, Kansas 66612-1367**  
 Board of Agriculture, Division of Water Resources  
 Application Number:

3 LOCATE WELL'S LOCATION WITH AN "X" IN SECTION BOX:  


4 DEPTH OF COMPLETED WELL: **30** ft. ELEVATION: **1170.22**  
 Depth(s) Groundwater Encountered 1. \_\_\_\_\_ ft. 2. \_\_\_\_\_ ft. 3. \_\_\_\_\_ ft.  
 WELL'S STATIC WATER LEVEL \_\_\_\_\_ ft. below land surface measured on mo/day/yr  
 Pump test data: Well water was **NA** ft. after \_\_\_\_\_ hours pumping \_\_\_\_\_ gpm  
 Est. Yield **NA** gpm: Well water was \_\_\_\_\_ ft. after \_\_\_\_\_ hours pumping \_\_\_\_\_ gpm  
 Bore Hole Diameter **.60** in. to **.30** ft., and \_\_\_\_\_ in. to \_\_\_\_\_ ft.  
 WELL WATER TO BE USED AS: 5 Public water supply 8 Air conditioning 11 Injection well  
 1 Domestic 3 Feedlot 6 Oil field water supply 9 Dewatering **12 Other (Specify below)**  
**Air sparge, SVE**  
 2 Irrigation 4 Industrial 7 Lawn and garden only 10 Monitoring well  
 Was a chemical/bacteriological sample submitted to Department? Yes \_\_\_\_\_ No  If yes, mo/day/yr sample was submitted  
 Water Well Disinfected? Yes \_\_\_\_\_ No

5 TYPE OF BLANK CASING USED:  
 1 Steel 3 RMP (SR) 5 Wrought iron 8 Concrete tile CASING JOINTS: Glued \_\_\_\_\_ Clamped \_\_\_\_\_  
**2 PVC** 4 ABS 6 Asbestos-Cement 9 Other (specify below) Welded \_\_\_\_\_  
 7 Fiberglass Threaded   
 Blank casing diameter **2 (4)** in. to **28 (10)** ft., Dia \_\_\_\_\_ in. to \_\_\_\_\_ ft., Dia \_\_\_\_\_ in. to \_\_\_\_\_ ft.  
 Casing height above land surface **-1.56** in., weight \_\_\_\_\_ lbs./ft. Wall thickness or gauge No. **Sch. 40**  
 TYPE OF SCREEN OR PERFORATION MATERIAL  
 1 Steel 3 Stainless steel 5 Fiberglass **7 PVC** 10 Asbestos-cement  
 2 Brass 4 Galvanized steel 6 Concrete tile 8 RMP (SR) 11 Other (specify) \_\_\_\_\_  
 12 None used (open hole)  
 SCREEN OR PERFORATION OPENINGS ARE:  
 1 Continuous slot **3 Mill slot** 5 Gauzed wrapped 8 Saw cut 11 None (open hole)  
 2 Louvered shutter 4 Key punched 6 Wire wrapped 9 Drilled holes  
 7 Torch cut 10 Other (specify) \_\_\_\_\_  
 SCREEN-PERFORATED INTERVALS: From **28 (10)** ft. to **30 (20)** ft., From \_\_\_\_\_ ft. to \_\_\_\_\_ ft.  
 From \_\_\_\_\_ ft. to \_\_\_\_\_ ft., From \_\_\_\_\_ ft. to \_\_\_\_\_ ft.  
 GRAVEL PACK INTERVALS: From **0** ft. to **1 (rock)** ft., From **1** ft. to **5** ft.  
 From **8** ft. to **30** ft., From \_\_\_\_\_ ft. to \_\_\_\_\_ ft.

6 GROUT MATERIAL: 1 Neat cement 2 Cement grout 3 Bentonite **4 Other Concrete**  
 Grout intervals: From **5** ft. to **8** ft., From \_\_\_\_\_ ft. to \_\_\_\_\_ ft., From \_\_\_\_\_ ft. to \_\_\_\_\_ ft.  
 What is the nearest source of possible contamination:  
 1 Septic tank 4 Lateral lines 7 Pit privy 10 Livestock pens 14 Abandoned water well  
 2 Sewer lines 5 Cess pool 8 Sewage lagoon 11 Fuel storage 15 Oil well/Gas well  
 3 Watertight sewer lines 6 Seepage pit 9 Feedyard 12 Fertilizer storage **16 Other (specify below)**  
**Abdn fuel storage**  
 13 Insecticide storage  
 Direction from well? \_\_\_\_\_ How many feet? \_\_\_\_\_

FROM	TO	LITHOLOGIC LOG	FROM	TO	PLUGGING INTERVALS
0	0.5	Gravel,			
0.5	1	Clay (topsoil), silty, w/roots, Med. Brown			
1	5	Clay, silty, Black			Nested wells in same large diameter boring.
5	7.5	Silt, clayey, Med. Gray			
7.5	13	Silt, Lt. Gray			
13	17	Silt, sl. sandy, Lt. Gray			
17	24	Silt, sl. clayey to sandy, Lt. Gray			
24	27	Sand, c. silty, Lt. Gray			
27	30	Gravel, Tan			
					AS7 and SVE7

7 CONTRACTOR'S OR LANDOWNER'S CERTIFICATION: This water well was **(1)** constructed, (2) reconstructed, or (3) plugged under my jurisdiction and was completed on (mo/day/year) **7/6/2011** and this record is true to the best of my knowledge and belief.  
 Kansas Water Well Contractor's License No. **527** This Water Well Record was completed on (mo/day/yr) **7/25/11**  
 under the business name of **GeoCore, Inc.** by (signature) *John Bell*

INSTRUCTIONS: Use typewriter or ball point pen. PLEASE PRESS FIRMLY and PRINT clearly. Please fill in blanks, underline or circle the correct answers. Send top three copies to Kansas Department of Health and Environment, Bureau of Water, Topeka, Kansas 66620-0001. Telephone: 913-296-5545. Send one to WATER WELL OWNER and retain one for your records.

OFFICE USE ONLY

T

R

EW

SEC

¼

¼

¼