


**WATER WELL RECORD**

**Form WWC-5**

Division of Water Resources App. No.  

<b>1 LOCATION OF WATER WELL:</b> County: Dickinson	Fraction NW ¼ SW ¼ SW ¼ NW ¼	Section Number 23	Township No. T 13 S	Range Number R 1 <input checked="" type="checkbox"/> E <input type="checkbox"/> W
Street/Rural Address of Well Location; if unknown, distance & direction from nearest town or intersection: If at owner's address, check here <input type="checkbox"/> 3 miles West of Abilene, Kansas		<b>Global Positioning System (GPS) information:</b> Latitude: .38,90927365..... (in decimal degrees) Longitude: 97.29770007..... (in decimal degrees) Elevation: 1194..... Datum: <input type="checkbox"/> WGS 84, <input checked="" type="checkbox"/> NAD 83, <input type="checkbox"/> NAD 27 <b>Collection Method:</b> <input type="checkbox"/> GPS unit (Make/Model: .....) <input type="checkbox"/> Digital Map/Photo, <input type="checkbox"/> Topographic Map, <input type="checkbox"/> Land Survey Est. Accuracy: <input type="checkbox"/> <3 m, <input type="checkbox"/> 3-5 m, <input type="checkbox"/> 5-15 m, <input type="checkbox"/> >15 m		

<b>2 WATER WELL OWNER:</b> City of Abilene c/o Jay Leusman RR#, Street Address, Box #: PO Box 519 City, State, ZIP Code : Abilene, Kansas 67410	
---	--

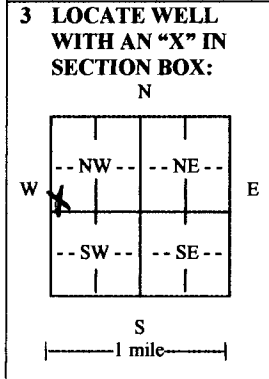

**4 DEPTH OF COMPLETED WELL** 84..... ft.

Depth(s) Groundwater Encountered (1)..... ft. (2)..... ft. (3)..... ft.

WELL'S STATIC WATER LEVEL..... 50..... ft. below land surface measured on mo/day/yr. 5/13/2015.....

Pump test data: Well water was..... ft. after..... hours pumping..... gpm

EST. YIELD. 30..... gpm. Well water was..... ft. after..... hours pumping..... gpm

Bore Hole Diameter .5..... in. to 84..... ft., and..... in. to..... ft.

WELL WATER TO BE USED AS:  Public water supply  Geothermal  Injection well  
 Domestic  Feedlot  Oil field water supply  Dewatering  Other (Specify below)  
 Irrigation  Industrial  Domestic-lawn & garden  Monitoring well .....

Was a chemical/bacteriological sample submitted to Department?  Yes  No  
 If yes, mo/day/yr sample was submitted.....

Water well disinfected?  Yes  No

**5 TYPE OF CASING USED:**  Steel  PVC  Other .....

CASING JOINTS:  Glued  Clamped  Welded  Threaded

Casing diameter .2..... in. to 64..... ft., Diameter..... in. to..... ft., Diameter..... in. to..... ft.  
 Casing height above land surface..... 12..... in., Weight..... 703..... lbs./ft., Wall thickness or gauge No. .... 0.154.....

TYPE OF SCREEN OR PERFORATION MATERIAL:  
 Steel  Stainless Steel  PVC  Other (Specify) .....

Brass  Galvanized Steel  None used (open hole)

SCREEN OR PERFORATION OPENINGS ARE:  
 Continuous slot  Mill slot  Gauze wrapped  Torch cut  Drilled holes  None (open hole)  
 Louvered shutter  Key punched  Wire wrapped  Saw cut  Other (specify) .....

SCREEN-PERFORATED INTERVALS: From..... 64..... ft. to 84..... ft., From..... ft. to..... ft.  
 From..... ft. to..... ft., From..... ft. to..... ft.

GRAVEL PACK INTERVALS: From..... 25..... ft. to 84..... ft., From..... ft. to..... ft.  
 From..... ft. to..... ft., From..... ft. to..... ft.

**6 GROUT MATERIAL:**  Neat cement  Cement grout  Bentonite  Other .....

Grout Intervals: From..... 0..... ft. to 25..... ft., From..... ft. to..... ft., From..... ft. to..... ft.

What is the nearest source of possible contamination:  
 Septic tank  Lateral lines  Pit privy  Livestock pens  Insecticide storage  Other (specify below)  
 Sewer lines  Cesspool  Sewage lagoon  Fuel storage  Abandoned water well  
 Watertight sewer lines  Seepage pit  Feedyard  Fertilizer storage  Oil well/gas well .....

Direction from well Nonw within 1/4 mile..... Distance from well.....

FROM	TO	LITHOLOGIC LOG	FROM	TO	LITHO. LOG (cont.) or PLUGGING INTERVALS
0	3	Topsoil	79	84	Shale, dark gray
3	19	Sand, fine			
19	21	Clay			
21	24	Sand, fine			
24	43	Sand, silty			
43	67	Shale			
67	67.5	Limestone			
67.5	-	Fracture- small			
67.5	79	Shale			
79	-	Fracture below limestone			

**7 CONTRACTOR'S OR LANDOWNER'S CERTIFICATION:** This water well was  constructed,  reconstructed, or  plugged under my jurisdiction and was completed on (mo/day/year) 5/13/2015..... and this record is true to the best of my knowledge and belief. Kansas Water Well Contractor's License No. ... 897..... This Water Well Record was completed on (mo/day/year) 5/26/15..... under the business name of Peterson McNett Drilling, Inc..... by (signature) *Peter McNett*

**INSTRUCTIONS:** Use typewriter or ball point pen. PLEASE PRESS FIRMLY and PRINT clearly. Please fill in blanks and check the correct answers. Send one copy to Kansas Department of Health and Environment, Bureau of Water, Geology Section, 1000 SW Jackson St., Suite 420, Topeka, Kansas 66612-1367. Telephone 785-296-5524. Send one copy to WATER WELL OWNER and retain one for your records. Include fee of \$5.00 for each constructed well. Visit us at <http://www.kdheks.gov/waterwell/index.html>