


1 LOCATION OF WATER WELL: Fraction SW 1/4 SW 1/4 NE 1/4 Section Number 36 Township Number T13 Range Number R11 E/W (N)
 County: Bushell

Distance and direction from nearest town or city street address of well if located within city?
3 mi. West of Wilson Ks, then 2 1/2 mi. North

2 WATER WELL OWNER: Herald Steiner Wilson, KS. 67490
 RR#, St. Address, Box #: [REDACTED] - RB 20491-170 RD Board of Agriculture, Division of Water Resources
 City, State, ZIP Code: [REDACTED] PO Box N Application Number:

3 LOCATE WELL'S LOCATION WITH AN "X" IN SECTION BOX:

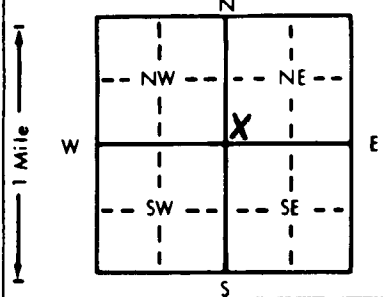

4 DEPTH OF COMPLETED WELL: 110 ft ft. ELEVATION: ft.
 Depth(s) Groundwater Encountered 100 ft. 2. ft. 3. ft.
 WELL'S STATIC WATER LEVEL 90 ft. below land surface measured on 5/24/98
 Pump test data: Well water was 86 ft. after Continuous hours pumping 28 gpm
 Est. Yield gpm: Well water was ft. after hours pumping gpm
 Bore Hole Diameter 8 in. to 110 ft., and in. to ft.
 WELL WATER TO BE USED AS: 5 Public water supply 8 Air conditioning 11 Injection well
 Domestic 3 Feedlot 6 Oil field water supply 9 Dewatering Other (Specify below)
 2 Irrigation 4 Industrial 7 Lawn and garden only 10 Monitoring well Cattle
 Was a chemical/bacteriological sample submitted to Department? Yes No X; If yes, mo/day/yr sample was submitted
 Water Well Disinfected? Yes X No

5 TYPE OF BLANK CASING USED: 5 Wrought iron 8 Concrete tile CASING JOINTS: Glued Clamped
 1 Steel 3 RMP (SR) 6 Asbestos-Cement 9 Other (specify below) Welded
 PVC 4 ABS 7 Fiberglass Threaded
 Blank casing diameter 5 in. to 98 ft., Dia in. to ft., Dia in. to ft.
 Casing height above land surface 12 in., weight lbs./ft. Wall thickness or gauge No. Sch 300

TYPE OF SCREEN OR PERFORATION MATERIAL: PVC 10 Asbestos-cement
 1 Steel 3 Stainless steel 5 Fiberglass 8 RMP (SR) 11 Other (specify)
 2 Brass 4 Galvanized steel 6 Concrete tile 9 ABS 12 None used (open hole)

SCREEN OR PERFORATION OPENINGS ARE: 5 Gauzed wrapped 8 Saw cut 11 None (open hole)
 1 Continuous slot 3 Mill slot 6 Wire wrapped 9 Drilled holes
 2 Louvered shutter 4 Key punched 7 Torch cut Other (specify) factory cut

SCREEN-PERFORATED INTERVALS: From 98 ft. to 110 ft., From ft. to ft.
 From ft. to ft., From ft. to ft.
 GRAVEL PACK INTERVALS: From 25 ft. to 110 ft., From ft. to ft.
 From ft. to ft., From ft. to ft.

6 GROUT MATERIAL: 1 Neat cement Cement grout 3 Bentonite 4 Other
 Grout Intervals: From 0 ft. to 25 ft., From ft. to ft., From ft. to ft.
 What is the nearest source of possible contamination: 10 Livestock pens 14 Abandoned water well
 1 Septic tank 4 Lateral lines 7 Pit privy 11 Fuel storage 15 Oil well/Gas well
 2 Sewer lines 5 Cess pool 8 Sewage lagoon 12 Fertilizer storage Other (specify below)
 3 Watertight sewer lines 6 Seepage pit 9 Feedyard Creek to east
 Direction from well? How many feet?

| FROM | TO | LITHOLOGIC LOG | FROM | TO | PLUGGING INTERVALS |
|------|-----|----------------|------|----|--------------------|
| 0 | 13 | Topsoil | | | |
| 13 | 36 | Shale | | | |
| 36 | 40 | Sand rock | | | |
| 40 | 49 | Sand Shale | | | |
| 49 | 63 | Sand rock | | | |
| 63 | 65 | Shale | | | |
| 65 | 103 | Sand Shale | | | |
| 103 | 110 | Sand rock | | | |

7 CONTRACTOR'S OR LANDOWNER'S CERTIFICATION: This water well was constructed, (2) reconstructed, or (3) plugged under my jurisdiction and was completed on (mo/day/year) 5/24/98 and this record is true to the best of my knowledge and belief. Kansas
 Water Well Contractor's License No. 619 This Water Well Record was completed on (mo/day/yr) 6/14/98
 under the business name of Bushell Waterwell Services by (signature) Beta J. Bushell