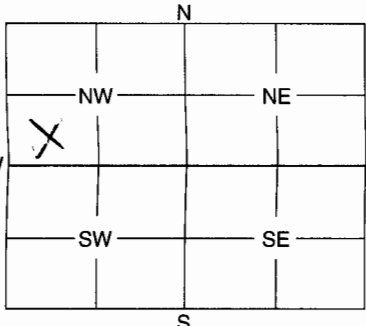


1	LOCATION OF WATER WELL:	Fraction <u>NW</u> $\frac{1}{4}$ $\frac{1}{4}$ $\frac{1}{4}$	Section Number <u>35</u>	Township Number <u>13</u>	Range Number <u>12</u> E/W																								
County: <u>WABAWNEE</u> Distance and direction from nearest town or city street address of well if located within city? <u>E. of Eskridge on K4 Hwy 1 mile to Wakarusa Rd. 1 1/2 on E. to Pleasant Plain Rd.</u>																													
2	WATER WELL OWNER: <u>Gene Murray</u> RR #, St. Address, Box #: <u>11139 SW 101st</u> City, State, ZIP Code: <u>Auburn, KS. 66402</u> Board of Agriculture, Division of Water Resources Application Number: _____																												
3	MARK WELL'S LOCATION WITH AN "X" IN SECTION BOX: <div style="text-align: center;">  </div>		4 DEPTH OF WELL <u>22</u> ft. WELL'S STATIC WATER LEVEL <u>3</u> ft. WELL WAS USED AS: <div style="display: flex; justify-content: space-between;"> <div> 1 Domestic 2 Irrigation 3 Feedlot 4 Industrial </div> <div> 5 Public Water Supply 6 Oil Field Water Supply 7 Domestic (Lawn & Garden) 8 Air Conditioning </div> <div> 9 Dewatering 10 Monitoring Well 11 Injection Well 12 Other </div> </div>																										
Was a chemical / bacteriological sample submitted to Department? Yes No <input checked="" type="checkbox"/> If yes, mo/day/yr sample was submitted Water Well Disinfected: Yes <input checked="" type="checkbox"/> No																													
5	TYPE OF BLANK CASING USED: <div style="display: flex; justify-content: space-between;"> <div> 1 Steel 2 PVC </div> <div> 3 RMP (SR) 4 ABS </div> <div> 5 Wrought 6 Asbestos-Cement </div> <div> 7 Fiberglass 8 Concrete Tile </div> <div> 9 Other (Specify below) </div> </div> Blank casing diameter in. Was casing pulled? Yes No If yes, how much Casing height above or below land surface in.																												
6	GROUT PLUG MATERIAL: 1 Neat cement 2 Cement grout <u>3 Bentonite</u> 4 Other Grout Plug Intervals: From ft. to ft., From ft. to ft., From to ft. What is the nearest source of possible contamination: <div style="display: flex; justify-content: space-between;"> <div> 1 Septic tank 2 Sewer lines 3 Watertight sewer lines 4 Lateral lines 5 Cess pool </div> <div> 6 Seepage pit 7 Pit privy 8 Sewage lagoon 9 Feedyard <u>10 Livestock pens</u> </div> <div> 11 Fuel storage 12 Fertilizer storage 13 Insecticide storage 14 Abandoned water well 15 Oil well/Gas well </div> <div> 16 Other (specify below) </div> </div> Direction from well? How many feet?																												
<table border="1" style="width:100%; border-collapse: collapse;"> <thead> <tr> <th style="width:10%;">FROM</th> <th style="width:10%;">TO</th> <th style="width:80%;">PLUGGING MATERIALS</th> </tr> </thead> <tbody> <tr> <td><u>22</u></td> <td><u>5</u></td> <td><u>GRAVEL</u></td> </tr> <tr> <td><u>5.0</u></td> <td><u>4.4</u></td> <td><u>SUBSOIL</u></td> </tr> <tr> <td><u>4.4</u></td> <td><u>3.8</u></td> <td><u>BENTONITE</u></td> </tr> <tr> <td><u>3.8</u></td> <td><u>0</u></td> <td><u>TOP SOIL</u></td> </tr> <tr><td> </td><td> </td><td> </td></tr> <tr><td> </td><td> </td><td> </td></tr> <tr><td> </td><td> </td><td> </td></tr>
7	CONTRACTOR'S OF LANDOWNER'S CERTIFICATION: This water well was plugged under my jurisdiction and was completed on (mo/day/year) <u>11-2-06</u> and this record is true to the best of my knowledge and belief. Kansas Water Well Contractor's License No. <u>11-2-06</u> under the business name of <u>Bob's Backhoe Service LLC</u> by (signature) <u>Bob Bryan</u>																												
INSTRUCTIONS: Use typewriter or ball point pen. Please press firmly and print clearly. Please fill in blanks, underline or circle the correct answers. Send top three copies to Kansas Department of Health and Environment, Bureau of Water, Geology Section, 1000 SW Jackson St., Ste. 420, Topeka, Kansas 66612-1367. Telephone: 785/296-5522. Send one to Water Well Owner and retain one for your records.																													