


WATER WELL RECORD

Form WWC-5

Division of Water Resources App. No.

1 LOCATION OF WATER WELL: County: Russell, Fraction: 1/4 SE 1/4 SE 1/4 NW 1/4, Section Number: 7, Township No. T 13 S, Range Number R 12 E NW. Street/Rural Address of Well Location; if unknown, distance & direction from nearest town or intersection: From Russell KS 251 South to F70, F70 East to 193RD North on 193RD to Salt Creek RD, Salt Creek RD East to 1935+ turn North 3/10 Right Side Entry.

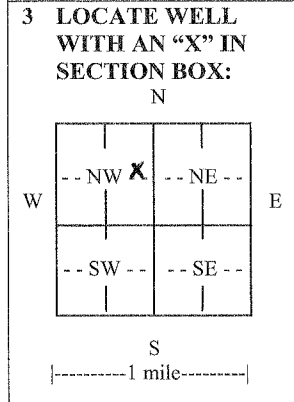

2 WATER WELL OWNER: Todd Dauber, RR#, Street Address, Box #: 103 Hampton CT, City, State, ZIP Code: Garden City, KS 67846. 3 LOCATE WELL WITH AN 'X' IN SECTION BOX: N, W, E, S. 4 DEPTH OF COMPLETED WELL: 8.5 ft. Depth(s) Groundwater Encountered (1) 7.5 ft. (2) ft. (3) ft. WELL'S STATIC WATER LEVEL: 32 ft. below land surface measured on mo/day/yr. 10-17-12. Pump test data: Well water was ft. after hours pumping gpm. EST. YIELD: 20 gpm. Well water was ft. after hours pumping gpm. Bore Hole Diameter: 8 in. to 8.5 ft., and in. to ft. WELL WATER TO BE USED AS: Public water supply, Geothermal, Injection well, Domestic, Feedlot, Oil field water supply, Dewatering, Other (Specify below), Irrigation, Industrial, Domestic-lawn & garden, Monitoring well. Was a chemical/bacteriological sample submitted to Department? Yes No. If yes, mo/day/yr sample was submitted. Water well disinfected? Yes No.

5 TYPE OF CASING USED: Steel, PVC, Other. CASING JOINTS: Glued, Clamped, Welded, Threaded. Casing diameter: 5 in. to 8.5 ft., Diameter in. to ft., Diameter in. to ft. Casing height above land surface: 2.5 in., Weight: 160 lbs./ft., Wall thickness or gauge No.: 50R.26. TYPE OF SCREEN OR PERFORATION MATERIAL: Steel, Stainless Steel, PVC, Brass, Galvanized Steel, None used (open hole), Other (Specify). SCREEN OR PERFORATION OPENINGS ARE: Continuous slot, Mill slot, Gauze wrapped, Torch cut, Drilled holes, None (open hole), Louvered shutter, Key punched, Wire wrapped, Saw cut, Other (specify). SCREEN-PERFORATED INTERVALS: From 8.5 ft. to 6.5 ft., From ft. to ft., From ft. to ft. GRAVEL PACK INTERVALS: From 8.5 ft. to 2.0 ft., From ft. to ft., From ft. to ft.

6 GROUT MATERIAL: Neat cement, Cement grout, Bentonite, Other. Grout Intervals: From 20 ft. to 0 ft., From ft. to ft., From ft. to ft. What is the nearest source of possible contamination: Septic tank, Lateral lines, Pit privy, Livestock pens, Insecticide storage, Other (specify below), Sewer lines, Cesspool, Sewage lagoon, Fuel storage, Abandoned water well, Watertight sewer lines, Seepage pit, Feedyard, Fertilizer storage, Oil well/gas well. Direction from well Distance from well

Table with columns: FROM, TO, LITHOLOGIC LOG, FROM, TO, LITHO. LOG (cont.) or PLUGGING INTERVALS. Rows: 0-3 Topsoil, 3-15 Limestone + brown clay, 15-30 Brown + red clay, 30-45 Blue clay, 45-60 Blue clay + grey clay, 60-75 Red clay white clay sandstone, 75-85 sandstone grey clay.

7 CONTRACTOR'S OR LANDOWNER'S CERTIFICATION: This water well was constructed, reconstructed, or plugged under my jurisdiction and was completed on (mo/day/year) Oct. 17-12, and this record is true to the best of my knowledge and belief. Kansas Water Well Contractor's License No. 776. This Water Well Record was completed on (mo/day/year) 11-13-12 under the business name of Rainey Water Well by (signature) Tony Rainey.

INSTRUCTIONS: Use typewriter or ball point pen. PLEASE PRESS FIRMLY and PRINT clearly. Please fill in blanks and check the correct answers. Send three copies (white, blue, pink) to Kansas Department of Health and Environment, Bureau of Water, Geology Section, 1000 SW Jackson St., Suite 420, Topeka, Kansas 66612-1367. Telephone 785-296-5524. Send one copy to WATER WELL OWNER and retain one for your records. Include fee of \$5.00 for each constructed well. Visit us at http://www.kdheks.gov/waterwell/index.html.