USE TYPEWRITER OR BALL POINT PEN-PRESS FIRMLY, PRINT CLEARLY.

WATER WELL RECORD
KSA 82a-1201-1215

Kansas Department of Health and Environment-Division of Environment
(Water well Contractors)
Topeka, Kansas 66620

1. Location of well:	County: Russell	Fraction: NE 1/4 1/4 1/4	Section number: 33	Township number: T 13 S	Range number: R 12 E/W

2. Distance and direction from nearest town or city: 3 mi East of Bunker Hill ½ mi North
Street address of well location if in city:

3. Owner of well: Al Steinle
R.R. or street:
City, state, zip code: Larsonce, Kans. 67634

4. Locate with "X" in section below:

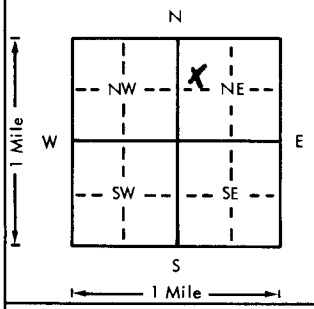

Sketch map:

This is All

6. Bore hole dia. 8 in. Completion date
Well depth 255 ft. 1-7-78

7. X Cable tool __ Rotary __ Driven __ Dug
__ Hollow rod __ Jetted __ Bored __ Reverse rotary

8. Use: __ Domestic __ Public supply __ Industry
__ Irrigation __ Air conditioning X Stock
__ Lawn __ Oil field water __ Other

9. Casing: Material
Threaded __ Welded __
RMP __ PVC X
Dia. 4 in. to 245 ft. depth
Dia. __ in. to __ ft. depth
Height: Above or below Surface 12 in.
Weight __ lbs./ft.
Wall Thickness: inches or gage No. SCH 40

10. Screen: Manufacturer's name Pumpco's
Type PVC Dia. 4"
Slot gauze fine Length 10
Set between 245 ft. and 255 ft.
ft. and ft.
Gravel pack? X Size range of material 3/16 x 3/8

11. Static water level: mo./day/yr.
235 ft. below land surface Date 1-5-78

12. Pumping level below land surfaces:
ft. after hrs. pumping g.p.m.
ft. after hrs. pumping g.p.m.
Estimated maximum yield 15 g.p.m.

13. Water sample submitted: mo./day/yr.
__ Yes X No Date

14. Well head completion:
__ Pitless adapter 12" Inches above grade

15. Well grouted? X
With: __ Neat cement __ Bentonite X Concrete
Depth: From 0 ft. to 25 230-243

16. Nearest source of possible contamination:
ft. 50' Direction West Type Barn
Well disinfected upon completion? X Yes __ No

17. Pump: __ Not installed
Manufacturer's name
Model number HP Volts
Length of drop pipe ft. capacity g.p.m.
Type:
__ Submersible Windmill __ Turbine
__ Jet __ Reciprocating
__ Centrifugal __ Other

5. Type and color of material	From	To
Yellow Lime Rock	0	15
Dark Shale	15	120
Shale + Sand	120	140
Light Gray Shale	140	246
Sand Rock Pink	246	255

(Use a second sheet if needed)

18. Elevation:

Topography:
__ Hill
X Slope
__ Upland
__ Valley

19. Remarks:

20. Water well contractor's certification:
This well was drilled under my jurisdiction and this report is true to the best of my knowledge and belief.
S Malls 360
Business name License No.
Address 95 South Kansas
Signed William T. Wagner 2-10-78
Authorized representative

T 13 R 12 E Sec 33 1/4 NE 1/4 1/4

Forward the white, blue and pink copies to the Department of Health and Environment

Form WWC-5

MI-1023