

County: Russell Fraction: SE NE SW Sec. 31 T. 13 S R. 13 W

CORRECTION(S) to WATER WELL COMPLETION RECORD Form WWC-5 (to rectify lacking or incorrect information)

Owner: Anderson Aerial Spraying MW 2

If location corrected, was listed as:

Section-Township-Range: 31-13-14

Fraction (¼ calls): SE NE SW

Location changed to:

31-13-13

Other changes: Initial statements: _____

Changed to: _____

Comments: _____

Verification method: Google maps and KGS mapper based on address on WWC-5


Initials: SH Date: 10/21/2019

Submitted by: Kansas Geological Survey, Data Resources Library, 1930 Constant Ave., Lawrence, KS 66047-3724
 Kansas Dept. of Health & Environment, Bureau of Water, 1000 SW Jackson, Suite 420, Topeka, KS 66612-1367

1	LOCATION OF WATER WELL:	Fraction	Section Number	Township Number	Range Number
	County: Russell	SE 1/4 NE 1/4 SW 1/4	31	13 S	14 W

Distance and direction from nearest town or city street address of well if located within city?
 4231 Airport Terrace, Russell, Kansas

2 WATER WELL OWNER: Anderson Aerial Spraying
 RR #, St. Address, Box #: P.O. Box 933 Board of Agriculture, Division of Water Resources
 City, State, ZIP Code: Russell, Kansas 67665 Application Number:

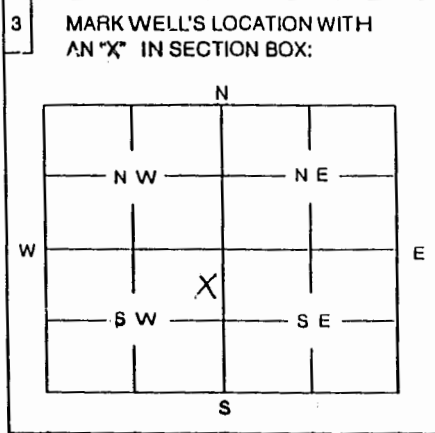

4 DEPTH OF WELL 52 ft
 WELL'S STATIC WATER LEVEL ft.
 WELL WAS USED AS:
 1 Domestic 5 Public Water Supply 9 Dewatering
 2 Irrigation 6 Oil Field Water Supply 10 Monitoring Well
 3 Feedlot 7 Domestic (Lawn & Garden) 11 Injection Well
 4 Industrial 8 Air Conditioning 12 Other

Was a chemical / bacteriological sample submitted to Department? Yes No X
 If yes, mo/day/yr sample was submitted

Water Well Disinfected: Yes No X

5 TYPE OF BLANK CASING USED:
 1 Steel 3 RMP (SR) 5 Wrought 7 Fiberglass 9 Other (Specify below)
 2 PVC 4 ABS 6 Asbestos-Cement 8 Concrete Tile

Blank casing diameter 2 in. Was casing pulled? Yes No X
 Casing height above or below land surface n/a in. If yes, how much 20'

6 GROUT PLUG MATERIAL: 1 Neat cement 2 Cement grout 3 Bentonite 4 Other

Grout Plug Intervals: From 0 ft. to 1 ft., From 1 ft. to 20 ft., From to ft.

What is the nearest source of possible contamination:
 1 Septic tank 6 Seepage pit 11 Fuel storage 16 Other (specify below) Former USI
 2 Sewer lines 7 Pit privy 12 Fertilizer storage
 3 Watertight sewer lines 8 Sewage lagoon 13 Insecticide storage
 4 Lateral lines 9 Feedyard 14 Abandoned water well
 5 Cess Pool 10 Livestock pens 15 Oil well/Gas well

Direction from well? Northwest How many feet? 35

FROM	TO	PLUGGING MATERIALS
0	1	Cement grout (8")
1	20	Bentonite (8")

8" overdrill to 20'

MW 2

7 CONTRACTOR'S OR LANDOWNER'S CERTIFICATION: This water well was plugged under my jurisdiction and was completed on (mo/day/year) 1/29/2004 and this record is true to the best of my knowledge and belief. Kansas Water Well Contractor's License No. 527. This Water Well Record was completed on (mo/day/year) 2/3/2004 under the business name of GeoCore Inc. by (signature) Dale Kolt

INSTRUCTIONS: Use typewriter or ball point pen. Please press firmly and print clearly. Please fill in blanks, underline or circle the correct answers. Send top three copies to Kansas Department of Health and Environment, Bureau of Water, Topeka, Kansas 66620-0001. Telephone: 785/296-3565. Send one to Water Well Owner and retain one for your records.