


1 LOCATION OF WATER WELL: County: Russell Fraction $\frac{1}{4}$ $\frac{1}{4}$ C $\frac{1}{4}$ SE $\frac{1}{4}$ Section Number 1 Township Number T 13 S Range Number 13 E W

Street/Rural Address of Well Location; if unknown, distance & direction from nearest town or intersection: If at owner's address, check here 4 mi N of Bunker Hill, KS

Global Positioning Systems (GPS) information:
 Latitude: _____ (in decimal degrees)
 Longitude: _____ (in decimal degrees)
 Elevation: _____
 Horizontal Datum: WGS84, NAD83, NAD27
 Collection Method: _____

2 WATER WELL OWNER: John Dolezal
 RR#, St. Address, Box #: 3212 202nd St
 City, State ZIP Code: Wilson KS 67490

GPS unit (Make/Model: _____)
 Digital Map/Photo, Topographic Map, Land Survey
 Est. Accuracy: <3 m, 3-5 m, 5-15 m, >15 m

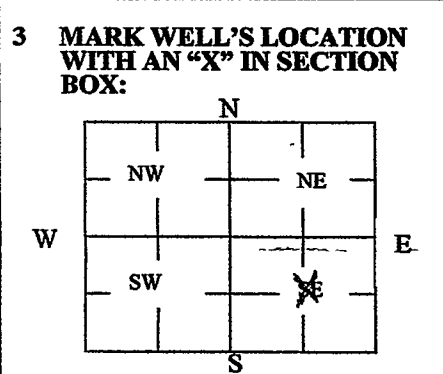

4 DEPTH OF WELL 305 ft.
 WELL'S STATIC WATER LEVEL 120 ft.
 WELL WAS USED AS:
 Domestic Irrigation Feedlot Industrial
 Public Water Supply Oil Field Water Supply Domestic (Lawn & Garden) Air Conditioning
 Dewatering Monitoring Injection Well Other _____

Was a chemical/bacteriological sample submitted to Department? Yes No

5 TYPE OF BLANK CASING USED:

Steel PVC RMP (SR) ABS Wrought Asbestos-Cement Fiberglass Concrete Tile Other (Specify below) _____

Blank casing diameter 5 in. Was casing pulled? Yes No If yes, how much 103 ft
 Casing height above or below land surface _____ in.

6 GROUT PLUG MATERIAL: Neat cement Cement grout Bentonite Other _____

Grout Plug Intervals: From 1 ft. to 23 ft., From 80 ft. to 156 ft., From _____ ft. to _____ ft.

What is the nearest source of possible contamination:
 Septic tank Sewer lines Watertight sewer lines Lateral lines Cess pool
 Seepage pit Pit privy Sewage lagoon Feedyard Livestock pens
 Fuel storage Fertilizer storage Insecticide storage Abandoned water well Oil well/Gas well
 Other (specify below) _____
 Direction from well? _____
 How many feet? _____

FROM	TO	PLUGGING MATERIALS	FROM	TO	PLUGGING MATERIALS
1	23	grout	23	80	gravel
80	156	grout			
156	305	gravel (fell in)			

7 CONTRACTOR'S OR LANDOWNER'S CERTIFICATION: This water well was plugged under my jurisdiction and was completed on (mo/day/year) 11/7/21 and this record is true to the best of my knowledge and belief. Kansas Water Well Contractor's License No. 870. This Water Well Record was completed on (mo/day/year) 1/27/22 under the business name of Bushnell Water Well Service by (signature) _____

Send one white copy to Kansas Department of Health & Environment, Geology Section, 1000 SW Jackson Street, Ste. 420, Topeka, KS 66612-1367. Send one copy to WATER WELL OWNER and retain one for your records.
 Visit us at <http://www.kdheks.gov/waterwell/index.html> Telephone 785-296-5524.