


1 LOCATION OF WATER WELL: County: Russell Fraction: SE 1/4 NW 1/4 NW 1/4 Section Number: 5 Township Number: T13 Range Number: R14 E/W: (W)

2 WATER WELL OWNER: Kurt Rujan  
 RR#, St. Address, Box #: 503 B SE 110 Ave.  
 City, State, ZIP Code: Ellinwood, KS 67526  
 Board of Agriculture, Division of Water Resources  
 Application Number:

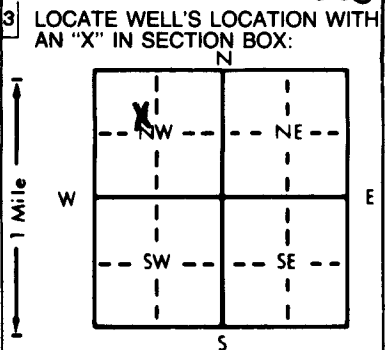

4 DEPTH OF COMPLETED WELL: 113.6 ft. ELEVATION: \_\_\_\_\_ ft.  
 Depth(s) Groundwater Encountered: 1. 31 ft. 2. \_\_\_\_\_ ft. 3. \_\_\_\_\_ ft.  
 WELL'S STATIC WATER LEVEL: 28 ft. below land surface measured on mo/day/yr  
 Pump test data: Well water was \_\_\_\_\_ ft. after \_\_\_\_\_ hours pumping 1 1/2 gpm  
 Est. Yield: 1 1/2 gpm; Well water was \_\_\_\_\_ ft. after \_\_\_\_\_ hours pumping \_\_\_\_\_ gpm  
 Bore Hole Diameter: 8" in. to 113.6" ft., and \_\_\_\_\_ in. to \_\_\_\_\_ ft.  
 WELL WATER TO BE USED AS:  
 1 Domestic 3 Feedlot 6 Oil field water supply 9 Dewatering 12 Other (Specify below)  
 2 Irrigation 4 Industrial 7 Lawn and garden only 10 Monitoring well  
 Was a chemical/bacteriological sample submitted to Department? Yes: 28 No: X; If yes, mo/day/yr sample was submitted  
 Water Well Disinfected? Yes No

5 TYPE OF BLANK CASING USED:  
 1 Steel 3 RMP (SR) 6 Asbestos-Cement 9 Other (specify below) Welded \_\_\_\_\_  
2 PVC 4 ABS 7 Fiberglass \_\_\_\_\_ Threaded \_\_\_\_\_  
 Blank casing diameter: 5 in. to 93.6 ft. Dia. 5 in. to 20 ft. Dia. \_\_\_\_\_ in. to \_\_\_\_\_ ft.  
 Casing height above land surface: 24 in., weight \_\_\_\_\_ lbs./ft. Wall thickness or gauge No. SCH 200  
 TYPE OF SCREEN OR PERFORATION MATERIAL:  
 1 Steel 3 Stainless steel 5 Fiberglass 8 RMP (SR) 10 Asbestos-cement 11 Other (specify) \_\_\_\_\_  
 2 Brass 4 Galvanized steel 6 Concrete tile 9 ABS 12 None used (open hole)  
 SCREEN OR PERFORATION OPENINGS ARE:  
 1 Continuous slot 3 Mill slot 5 Gauzed wrapped 8 Saw cut 11 None (open hole)  
 2 Louvered shutter 4 Key punched 6 Wire wrapped 9 Drilled holes  
 7 Torch cut 10 Other (specify) Factory Cut  
 SCREEN-PERFORATED INTERVALS: From 30 ft. to 50 ft., From \_\_\_\_\_ ft. to \_\_\_\_\_ ft.  
 From \_\_\_\_\_ ft. to \_\_\_\_\_ ft., From \_\_\_\_\_ ft. to \_\_\_\_\_ ft.  
 GRAVEL PACK INTERVALS: From 20 ft. to 113.6 ft., From \_\_\_\_\_ ft. to \_\_\_\_\_ ft.  
 From \_\_\_\_\_ ft. to \_\_\_\_\_ ft., From \_\_\_\_\_ ft. to \_\_\_\_\_ ft.

6 GROUT MATERIAL: 1 Neat cement 2 Cement grout 3 Bentonite 4 Other \_\_\_\_\_  
 Grout Intervals: From 0 ft. to 20 ft., From \_\_\_\_\_ ft. to \_\_\_\_\_ ft., From \_\_\_\_\_ ft. to \_\_\_\_\_ ft.  
 What is the nearest source of possible contamination:  
 1 Septic tank 4 Lateral lines 7 Pit privy 10 Livestock pens 14 Abandoned water well  
 2 Sewer lines 5 Cess pool 8 Sewage lagoon 11 Fuel storage 15 Oil well/Gas well  
 3 Watertight sewer lines 6 Seepage pit 9 Feedyard 12 Fertilizer storage 16 Other (specify below) river  
 13 Insecticide storage  
 Direction from well? \_\_\_\_\_ How many feet? \_\_\_\_\_

FROM	TO	LITHOLOGIC LOG	FROM	TO	PLUGGING INTERVALS
0	3	TOPSOIL			
3	28	Light tan clay			
28	52	Coarse gravel / Sand			
52	19	Light gray clay			
19	80	Red clay			
80	83	Sand Rock			
83	106	Red clay			
106	110	Sand rock			
110	113.6	Red Clay			

7 CONTRACTOR'S OR LANDOWNER'S CERTIFICATION: This water well was (1) constructed, (2) reconstructed, or (3) plugged under my jurisdiction and was completed on (mo/day/year) 11/06/97 and this record is true to the best of my knowledge and belief. Kansas Water Well Contractor's License No. 619 This Water Well Record was completed on (mo/day/yr) 11/20/97 under the business name of Bushell Waterwell Service by (signature) Rita J. Bushell