


1 LOCATION OF WATER WELL: County: Russell Fraction SE 1/4 SW 1/4 NW 1/4 Section Number 26 Township Number T 13 S Range Number R 14 E W
Distance and direction from nearest town or city street address of well if located within city? Located at 565 State Street in Russell Global Positioning Systems (decimal degrees, min. of 4 digits) Latitude: 38.893252 Longitude: -98.853482 Elevation: Unknown Datum: NAD83 Data Collection Method: WAAS GPS Unit

2 WATER WELL OWNER: Unified School District #407 RR#, St. Address, Box # : 802 Main City, State, ZIP Code : Russell, KS 67665

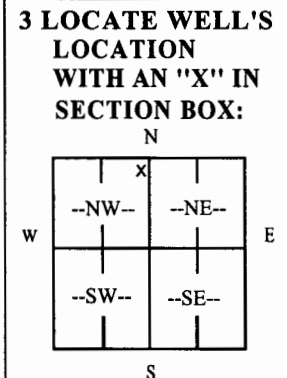

4 DEPTH OF COMPLETED WELL 33 ft.
Depth(s) Groundwater Encountered (1) ft. (2) ft. (3) ft.
WELL'S STATIC WATER LEVEL 12.55 ft. below land surface measured on mo/day/yr 03-16-07
Pump test data: Well water was Not checked ft. after hours pumping gpm
Est. Yield Unknown gpm: Well water was ft. after hours pumping gpm
WELL WATER TO BE USED AS: 5 Public water supply 8 Air conditioning 11 Injection well
1 Domestic 3 Feedlot 6 Oil field water supply 9 Dewatering 12 Other (Specify below) Test Well
2 Irrigation 4 Industrial 7 Domestic (lawn & garden) 10 Monitoring well
Was a chemical/bacteriological sample submitted to Department? Yes No If yes, mo/day/yr
Sample was submitted Water well disinfected? Yes No

5 TYPE OF CASING USED: 5 Wrought Iron 8 Concrete tile CASING JOINTS: Glued Clamped
1 Steel 3 RMP (SR) 6 Asbestos-Cement 9 Other (specify below) Welded
2 PVC 4 ABS 7 Fiberglass Threaded
Blank casing diameter 5 in. to 11 ft., Diameter in. to ft., Diameter in. to ft.
Casing height above land surface 24 in., weight 2.36 lbs./ft. Wall thickness or gauge No. .214

TYPE OF SCREEN OR PERFORATION MATERIAL:
1 Steel 3 Stainless Steel 5 Fiberglass 7 PVC 9 ABS 11 Other (Specify)
2 Brass 4 Galvanized Steel 6 Concrete tile 8 RM (SR) 10 Asbestos-Cement 12 None used (open hole)

SCREEN OR PERFORATION OPENINGS ARE:
1 Continuous slot 3 Mill slot 5 Gauzed wrapped 7 Torch cut 9 Drilled holes 11 None (open hole)
2 Louvered shutter 4 Key punched 6 Wire wrapped 8 Saw Cut 10 Other (Specify)

SCREEN-PERFORATED INTERVALS: From 11 ft. to 31 ft., From ft. to ft.
From ft. to ft., From ft. to ft.
GRAVEL PACK INTERVALS: From 9 ft. to 31 ft., From ft. to ft.
From ft. to ft., From ft. to ft.

6 GROUT MATERIAL: 1 Neat Cement 2 Cement grout 3 Bentonite 4 Other Bentonite Holeplug
Grout Intervals: From ft. to ft., From ft. to ft., From 0 ft. to 9 ft.

What is the nearest source of possible contamination:
1 Septic tank 4 Lateral lines 7 Pit privy 10 Livestock pens 13 Insecticide Storage 16 Other (specify below)
2 Sewer lines 5 Cess pool 8 Sewage lagoon 11 Fuel storage 14 Abandoned water well None known
3 Watertight sewer lines 6 Seepage pit 9 Feedyard 12 Fertilizer Storage 15 Oil well/gas well
Direction from well? How many feet?

FROM	TO	LITHOLOGIC LOG	FROM	TO	PLUGGING INTERVALS
0	2	Topsoil			
2	8	Clay, brown			
8	12	Clay, brown, with limestone and sand streaks			Note: Grout only taken to 9' due to shallow water level and shallow TD
12	18	Clay, brown			
18	21	Clay, gray, yellow, sandy, with limestone streaks, thin			
21	26	Clay, yellow, white, with limestone and sand streaks			
26	31	Clay, white, gray, with limestone, hard			
31	35	Shale, black			

7 CONTRACTOR'S OR LANDOWNER'S CERTIFICATION: This water well was (1) constructed (2) reconstructed (3) plugged under my jurisdiction and was completed on (mo/day/year) 03-16-07 and this record is true to the best of my knowledge and belief.
Kansas Water Well Contractor's License No. 185 This Water Well Record was completed on (mo/day/year) 3-21-07
Under the business name of Clarke Well & Equipment, Inc. by (signature) *Clarke Well & Equipment, Inc.*