

MW2


WATER WELL PLUGGING RECORD Form WWC-5P KSA 82a-1212 ID NO. 0042351

1 LOCATION OF WATER WELL: County: Russell Fraction SW 1/4 SE 1/4 SE 1/4 Section Number 34 Township Number 13 Range Number 19 E

Distance and direction from nearest town or city street address of well if located within city?

165 E. WITT RUSSELL KS

2 WATER WELL OWNER: KDOT RUSSELL RR#, St. Address, Box #: 165 E. WITT City, State ZIP Code: Russell, KS 67665 Global Positioning Systems (decimal degrees, min. of 4 digits) Latitude: 38.872008 Longitude: -98.857584 Elevation: 1036.39 Datum: Data Collection Method: Survey

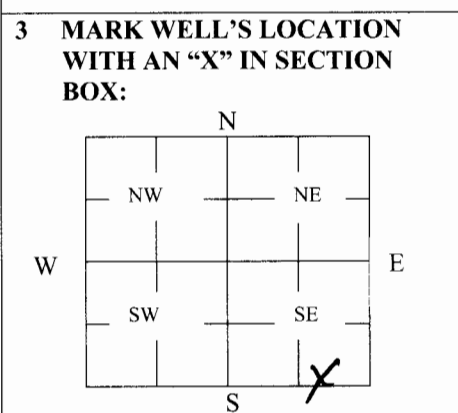

4 DEPTH OF WELL 40.05 ft. WELL'S STATIC WATER LEVEL 26.45 ft. WELL WAS USED AS: 1 Domestic 2 Irrigation 3 Feedlot 4 Industrial 5 Public Water Supply 6 Oil Field Water Supply 7 Domestic (Lawn & Garden) 8 Air Conditioning 9 Dewatering 10 Monitoring 11 Injection Well 12 Other Was a chemical/bacteriological sample submitted to Department? Yes No X

5 TYPE OF BLANK CASING USED: 1 Steel 2 PVC 3 RMP (SR) 4 ABS 5 Wrought 6 Asbestos-Cement 7 Fiberglass 8 Concrete Tile 9 Other (Specify below) Blank casing diameter 5 in. Was casing pulled? Yes X No If yes, how much 5' Casing height above or below land surface 36 in.

6 GROUT PLUG MATERIAL: 1 Neat cement 2 Cement grout 3 Bentonite 4 Other Grout Plug Intervals: From 40.05 ft. to 1 ft., From ft. to ft., From ft. to ft. What is the nearest source of possible contamination: 1 Septic tank 2 Sewer lines 3 Watertight sewer lines 4 Lateral lines 5 Cess pool 6 Seepage pit 7 Pit privy 8 Sewage lagoon 9 Feedyard 10 Livestock pens 11 Fuel Storage 12 Fertilizer storage 13 Insecticide storage 14 Abandoned water well 15 Oil well/Gas well 16 Other (specify below) Former Fuel Storage Direction from well? How many feet?

Table with columns: FROM, TO, PLUGGING MATERIALS. Row 1: 40.05, 1, Bentonite. Row 2: 1, Surface Soil.

7 CONTRACTOR'S OR LANDOWNER'S CERTIFICATION: This water well was plugged under my jurisdiction and was completed on (mo/day/year) 11/13 and this record is true to the best of my knowledge and belief. Kansas Water Well Contractor's License No. This Water Well Record was completed on (mo/day/year) 11/20/09 under the business name of Tank Management Services by (signature)

INSTRUCTIONS: Use typewriter or ballpoint pen. Please press firmly and print clearly. Please fill in blanks, underline or circle the correct answers. Send top three copies to Kansas Department of Health and Environment, Bureau of Water, Geology Section, 1000 SW Jackson St., Ste. 420, Topeka, Kansas 66612-1367. Telephone: 785/296-5522. Send one to Water Well Owner and retain one for your records. Visit us at http://www.kdheks.gov/geo/waterwells.