


1 LOCATION OF WATER WELL: Fraction SW 1/4 SE 1/4 SW 1/4 Section Number 27 Township Number T 13 S Range Number R 14 W

Distance and direction from nearest town or city street address of well if located within city? 615 W. Wichita, Russell KS.

2 WATER WELL OWNER: Kansas Department of Health and Environment RR#, St. Address, Box #: 1000 SW. Jackson St. Suite 410 Board of Agriculture, Division of Water Resources City, State, ZIP Code: Topeka, KS. 66612-1367 Application Number:

3 LOCATE WELL'S LOCATION WITH AN "X" IN SECTION BOX:

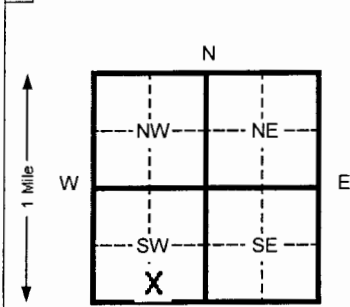

4 DEPTH OF COMPLETED WELL 15.15 ft. ELEVATION: Depth(s) Groundwater Encountered 11.5 9 ft. 2 ft. 3 ft. WELL'S STATIC WATER LEVEL 8.90 ft. below land surface measured on mo/day/yr 12/10/2009 Pump test data: Well water was Ft. after hours pumping Gpm Est. Yield Gpm: Well water was Ft. after Hours pumping Gpm Bore Hole Diameter 8.625 in. to 15 ft. and in. to ft. WELL WATER TO BE USED AS: 5 Public water supply 8 Air conditioning 11 Injection well 1 Domestic 3 Feed lot 6 Oil field water supply 9 Dewatering 12 Other (Specify below) 2 Irrigation 4 Industrial 7 Lawn and garden (domestic) 10 Monitoring well MW-6 Was a chemical/bacteriological sample submitted to Department? Yes No X If yes, mo/day/yr sample was Submitted Water Well Disinfected? Yes No X

5 TYPE OF BLANK CASING USED: 5 Wrought Iron 8 Concrete tile CASING JOINTS: Glued Clamped

Blank casing diameter 2 in. to 5 Dia SCH 40 Casing height above land surface FLUSH in., weight Lbs./ft. Wall thickness or gauge No. TYPE OF SCREEN OR PERFORATION MATERIAL: 7 PVC 10 Asbestos-cement

SCREEN OR PERFORATION OPENINGS ARE: 3 Mill slot 6 Wire wrapped 9 Drilled holes

SCREEN-PERFORATED INTERVALS: From 5 ft. to 15 ft. SAND PACK INTERVALS: From 4 ft. to 15 ft.

6 GROUT MATERIAL: 2 Cement grout 3 Bentonite 4 Other

Grout Intervals From 2 .5 1.5 2 From 3 2 to 4 ft. From ft. to ft.

What is the nearest source of possible contamination: 16 Other (specify below) Contaminated Site

Direction from well? How many feet? Table with columns FROM, TO, CODE, LITHOLOGIC LOG, FROM, TO, PLUGGING INTERVALS. Rows: 0-.5 Topsoil, silty clay loam; .5-5 Silty Clay (CL), dark brown; 5-14 Silty Clay (CL), olive-grey; 14-15 Silty Clay (CL), yellow-orange; 15-TD End Borehole

**CORRECTED**

7 CONTRACTOR'S OR LANDOWNER'S CERTIFICATION: This water well was (x) constructed, (2) reconstructed, or (3) plugged under my jurisdiction and was Completed on (mo/day/yr) 12/8/2009

Water Well Contractor's License No. 585 This Water Well Record was completed on (mo/day/yr) 1/6/2010

under the business name of Associated Environmental, Inc. By (signature) Bradley J Johnson

INSTRUCTIONS: Please fill in blanks and circle the correct answers. Send three copies to Kansas Department of Health and Environment, Bureau of Water, Topeka, Kansas 66620-0001. Telephone: 913-296-5545. Send one to WATER WELL OWNER and retain one for your records.

*Bradley J Johnson*

OFFICE USE ONLY

T

R