


1 LOCATION OF WATER WELL: County: Russell Fraction: NE 1/4 NW 4 1/4 NE 1/4 Section Number: 19 Township Number: T 13 S Range Number: R 14 E/W

Distance and direction from nearest town or city street address of well if located within city?
2 West And 1 1/2 North

2 WATER WELL OWNER: Triple S
 RR#, St. Address, Box #: 421 S. Van Houten Board of Agriculture, Division of Water Resources
 City, State, ZIP Code: Russell, Kansas 67665 Application Number: RS WW 0770

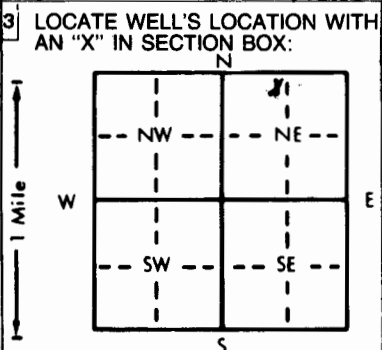

4 DEPTH OF COMPLETED WELL: 167 ft. ELEVATION: _____ ft.
 Depth(s) Groundwater Encountered 1. 160 ft. 2. _____ ft. 3. _____ ft.
 WELL'S STATIC WATER LEVEL: 130 ft. below land surface measured on mo/day/yr Jan. 17, 1998
 Pump test data: Well water was 142 ft. after 1 hours pumping 7 gpm
 Est. Yield 7 gpm: Well water was _____ ft. after _____ hours pumping _____ gpm
 Bore Hole Diameter: 8 in. to 167 ft., and _____ in. to _____ ft.
 WELL WATER TO BE USED AS:
 Domestic 3 Feedlot 6 Oil field water supply 9 Dewatering 12 Other (Specify below)
 2 Irrigation 4 Industrial 7 Lawn and garden only 10 Monitoring well
 Was a chemical/bacteriological sample submitted to Department? Yes No _____; If yes, mo/day/yr sample was submitted Jan. 22, 1998 Water Well Disinfected? Yes No

5 TYPE OF BLANK CASING USED:
 1 Steel 3 RMP (SR) 5 Wrought iron 8 Concrete tile CASING JOINTS: Glued _____ Clamped _____
 PVC 4 ABS 6 Asbestos-Cement 9 Other (specify below) Welded _____
 2 Brass 7 Fiberglass _____ Threaded _____
 Blank casing diameter 4 in. to 167 ft., Dia _____ in. to _____ ft., Dia _____ in. to _____ ft.
 Casing height above land surface 16 in., weight _____ lbs./ft. Wall thickness or gauge No. _____
 TYPE OF SCREEN OR PERFORATION MATERIAL: PVC 10 Asbestos-cement
 1 Steel 3 Stainless steel 5 Fiberglass 8 RMP (SR) 11 Other (specify) _____
 2 Brass 4 Galvanized steel 6 Concrete tile 9 ABS 12 None used (open hole)
 SCREEN OR PERFORATION OPENINGS ARE:
 1 Continuous slot Mill slot 5 Gauzed wrapped 8 Saw cut 11 None (open hole)
 2 Louvered shutter 4 Key punched 6 Wire wrapped 9 Drilled holes
 7 Torch cut 10 Other (specify) _____
 SCREEN-PERFORATED INTERVALS: From 167 ft. to 149 ft., From _____ ft. to _____ ft.
 From _____ ft. to _____ ft., From _____ ft. to _____ ft.
 GRAVEL PACK INTERVALS: From 167 ft. to 30 ft., From _____ ft. to _____ ft.
 From _____ ft. to _____ ft., From _____ ft. to _____ ft.

6 GROUT MATERIAL: Neat cement 2 Cement grout 3 Bentonite 4 Other _____
 Grout Intervals: From 30 ft. to 0 ft., From _____ ft. to _____ ft., From _____ ft. to _____ ft.
 What is the nearest source of possible contamination:
 1 Septic tank 4 Lateral lines 7 Pit privy 10 Livestock pens 14 Abandoned water well
 2 Sewer lines 5 Cess pool 8 Sewage lagoon 11 Fuel storage 15 Oil well/Gas well
 3 Watertight sewer lines 6 Seepage pit 9 Feedyard 12 Fertilizer storage 16 Other (specify below)
 13 Insecticide storage _____
 Direction from well? East 300 Ft. How many feet? _____

FROM	TO	LITHOLOGIC LOG	FROM	TO	PLUGGING INTERVALS
0	3	Top Soil			
3	12	yellow Clay And rock			
12	22	yellow Clay			
22	34	Soft Light Shale			
34	70	Dark Hard Shale			
70	76	Soft muddy Shale			
76	120	Dark Hard Shale			
120	142	Light Soft muddy Shale			
142	156	Dark Hard Shale			
156	167	Light sand Shale			

7 CONTRACTOR'S OR LANDOWNER'S CERTIFICATION: This water well was constructed, (2) reconstructed, or (3) plugged under my jurisdiction and was completed on (mo/day/year) Jan. 18, 1998 and this record is true to the best of my knowledge and belief. Kansas Water Well Contractor's License No. Self owned This Water Well Record was completed on (mo/day/yr) Jan. 30, 1998 under the business name of Triple S by (signature) Brad Standley