


Table with 5 columns: LOCATION OF WATER WELL: County: Russell; Fraction: SE 1/4, NE 1/4, NE 1/4; Section Number: 34; Township Number: T 13 S; Range Number: R 14 E/W

Distance and direction from nearest town or city street address of well if located within city? 237 S. Fossil Street, Russell

2 WATER WELL OWNER: Gene's Service

RR# St. Address, Box # : 206 E. Dorrance St. City, State, ZIP Code : Russell, Kansas 67665 Board of Agriculture, Division of Water Resources Application Number:

3 LOCATE WELL'S LOCATION WITH AN "X" IN SECTION BOX:

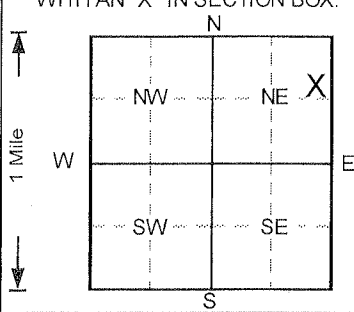

4 DEPTH OF COMPLETED WELL . . . 23 . . . ft. ELEVATION: 1834.63 Depth(s) Groundwater Encountered ft. ft. ft. ft. WELL'S STATIC WATER LEVEL . . . 18.49 . . . ft. below land surface measured on mo/day/yr 3/6/2012 Pump test data: Well water was . . . NA . . . ft. after hours pumping gpm Est. Yield . . NA . . gpm: Well water was ft. after hours pumping gpm Bore Hole Diameter . . . 8 . . . in. to . . . 23 . . . ft., and in. to ft. WELL WATER TO BE USED AS: 5 Public water supply 8 Air conditioning 11 Injection well 1 Domestic 3 Feedlot 6 Oil field water supply 9 Dewatering 12 Other (Specify below) 2 Irrigation 4 Industrial 7 Lawn and garden only 10 Monitoring well

5 TYPE OF BLANK CASING USED: 1 Steel 3 RMP (SR) 5 Wrought iron 8 Concrete tile CASING JOINTS: Glued Clamped 2 PVC 4 ABS 6 Asbestos-Cement 9 Other (specify below) Welded Threaded. checked. Blank casing diameter 2 in. to 13 ft. Dia in. to ft. Dia in. to ft. Casing height above land surface -5.04 in., weight lbs./ft. Wall thickness or gauge No. . . . Sch. 40 TYPE OF SCREEN OR PERFORATION MATERIAL 1 Steel 3 Stainless steel 5 Fiberglass 8 RMP (SR) 10 Asbestos-cement 2 Brass 4 Galvanized steel 6 Concrete tile 9 ABS 11 Other (specify) 12 None used (open hole) SCREEN OR PERFORATION OPENINGS ARE: 1 Continuous slot 3 Mill slot 5 Gauzed wrapped 8 Saw cut 11 None (open hole) 2 Louvered shutter 4 Key punched 6 Wire wrapped 9 Drilled holes 7 Torch cut 10 Other (specify) SCREEN-PERFORATED INTERVALS: From 13 ft. to 23 ft. From ft. to ft. GRAVEL PACK INTERVALS: From 11 ft. to 23 ft. From ft. to ft. From ft. to ft.

6 GROUT MATERIAL: 1 Neat cement 2 Cement grout 3 Bentonite 4 Other Concrete Grout Intervals: From 0 ft. to 1 ft. From 1 ft. to 11 ft. From ft. to ft. What is the nearest source of possible contamination: 1 Septic tank 4 Lateral lines 7 Pit privy 10 Livestock pens 14 Abandoned water well 2 Sewer lines 5 Cess pool 8 Sewage lagoon 11 Fuel storage 15 Oil well/Gas well 3 Watertight sewer lines 6 Seepage pit 9 Feedyard 12 Fertilizer storage 16 Other (specify below) 13 Insecticide storage Direction from well? How many feet?

LITHOLOGIC LOG table with columns FROM, TO, LITHOLOGIC LOG, FROM, TO, PLUGGING INTERVALS. Rows include Gravel and Sand (fill), Clay, silty, Dark Brown, Clay, v. silty, Brown, Silt, sl. clayey, Brown, Clay, occ. limestone clasts, Yellow, Clay, v. silty, Yellow mottled Lt. Gray. Includes well info: MW2, Tag # 0047632, Flushmount.

7 CONTRACTOR'S OR LANDOWNER'S CERTIFICATION: This water well was 1 constructed, 2 reconstructed, or 3 plugged under my jurisdiction and was completed on (mo/day/year) 3/2/2012 and this record is true to the best of my knowledge and belief. Kansas Water Well Contractor's License No. 527 This Water Well Record was completed on (mo/day/yr) 3/29/2012 under the business name of GeoCore, Inc. by (signature) Dale R. Bluff