


1 LOCATION OF WATER WELL: County: Russell Fraction SE 1/4 NE 1/4 NE 1/4 Section Number 34 Township Number T 13 S Range Number R 14 EW

Distance and direction from nearest town or city street address of well if located within city? 237 S. Fossil Street, Russell

2 WATER WELL OWNER: Gene's Service RR#, St. Address, Box #: 206 E. Dorrance St. City, State, ZIP Code: Russell, Kansas 67665 Board of Agriculture, Division of Water Resources Application Number:

3 LOCATE WELL'S LOCATION WITH AN "X" IN SECTION BOX:

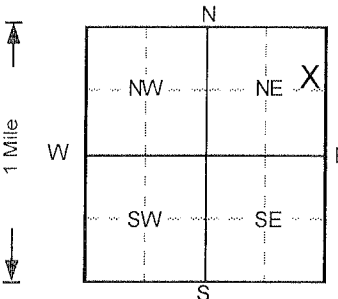

4 DEPTH OF COMPLETED WELL: 23 ft. ELEVATION: 1831.98. WELL'S STATIC WATER LEVEL: 17.99 ft. below land surface measured on 3/6/2012. Pump test data: Well water was NA ft. after hours pumping gpm. Est. Yield: NA gpm. Bore Hole Diameter: 8 in. to 23 ft. WELL WATER TO BE USED AS: 10 Monitoring well.

5 TYPE OF BLANK CASING USED: 2 PVC. Blank casing diameter: 2 in. Dia: 13 in. Casing height above land surface: -7.8 in., weight lbs./ft. Wall thickness or gauge No. Sch. 40. TYPE OF SCREEN OR PERFORATION MATERIAL: 7 PVC. SCREEN-OR PERFORATION OPENINGS ARE: 3 Mill slot. SCREEN-PERFORATED INTERVALS: From 13 ft. to 23 ft. GRAVEL PACK INTERVALS: From 11 ft. to 13 ft.

6 GROUT MATERIAL: 4 Other Concrete. Grout Intervals: From 0 ft. to 1 ft. From 1 ft. to 11 ft.

What is the nearest source of possible contamination: 10 Livestock pens, 14 Abandoned water well, 15 Oil well/Gas well, 16 Other (specify below).

Table with columns: FROM, TO, LITHOLOGIC LOG, FROM, TO, PLUGGING INTERVALS. Rows include lithologic logs: Clay, silty, Dark Brown; Clay, silty, Green Brown; Clay, Pale Green; Clay, occ. limestone clasts, Yellow. Plugging interval: MW7, Tag # 0047637, Flushmount.

7 CONTRACTOR'S OR LANDOWNER'S CERTIFICATION: This water well was (1) constructed, (2) reconstructed, or (3) plugged under my jurisdiction and was completed on 3/5/2012. Kansas Water Well Contractor's License No. 527. This Water Well Record was completed on 3/30/12 under the business name of GeoCore, Inc. by (signature) Dale Hill.