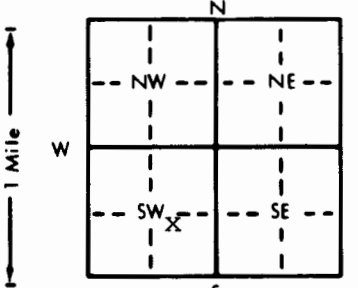


1 LOCATION OF WATER WELL: County: ~~Woods~~ Russell Fraction: NW 1/4 SE 1/4 SW 1/4 Section Number: 27 Township Number: T 13 S Range Number: R 14 E/W

Distance and direction from nearest town or city street address of well if located within city?  
208 Brooks Russell, Kansas

2 WATER WELL OWNER: Allan D. Evans  
RR#, St. Address, Box # : 208 Brooks Board of Agriculture, Division of Water Resources  
City, State, ZIP Code : Russell, Kansas 67665 Application Number:

3 LOCATE WELL'S LOCATION WITH AN "X" IN SECTION BOX:  4 DEPTH OF COMPLETED WELL: 30 ft. ELEVATION: Upland  
Depth(s) Groundwater Encountered 1. 9 ft. 2. ft. 3. ft.  
WELL'S STATIC WATER LEVEL 9 ft. below land surface measured on mo/day/yr 4/4/94  
Pump test data: Well water was 9 ft. after 1 hours pumping 20 gpm  
Est. Yield 20 gpm: Well water was ft. after hours pumping gpm  
Bore Hole Diameter 10 in. to 30 ft., and in. to ft.  
WELL WATER TO BE USED AS: 9 5 Public water supply 8 Air conditioning 11 Injection well  
1 Domestic 3 Feedlot 6 Oil field water supply 9 Dewatering 12 Other (Specify below)  
2 Irrigation 4 Industrial 7 Lawn and garden only 10 Monitoring well  
Was a chemical/bacteriological sample submitted to Department? Yes.....No........; If yes, mo/day/yr sample was submitted  
Water Well Disinfected? Yes  No

5 TYPE OF BLANK CASING USED: 2 5 Wrought iron 8 Concrete tile CASING JOINTS: Glued  Clamped  
1 Steel 3 RMP (SR) 6 Asbestos-Cement 9 Other (specify below) Welded  
2 PVC 4 ABS 7 Fiberglass Threaded  
Blank casing diameter 5 in. to 8 ft., Dia in. to ft., Dia in. to ft.  
Casing height above land surface 24 in., weight 2.29 lbs./ft. Wall thickness or gauge No. 26  
TYPE OF SCREEN OR PERFORATION MATERIAL: 7 7 PVC 10 Asbestos-cement  
1 Steel 3 Stainless steel 5 Fiberglass 8 RMP (SR) 11 Other (specify)  
2 Brass 4 Galvanized steel 6 Concrete tile 9 ABS 12 None used (open hole)  
SCREEN OR PERFORATION OPENINGS ARE: 8 5 Gauzed wrapped 8 Saw cut 11 None (open hole)  
1 Continuous slot 3 Mill slot 6 Wire wrapped 9 Drilled holes  
2 Louvered shutter 4 Key punched 7 Torch cut 10 Other (specify)  
SCREEN-PERFORATED INTERVALS: From 30 ft. to 8 ft., From ft. to ft.  
From ft. to ft., From ft. to ft.  
GRAVEL PACK INTERVALS: From 8 ft. to 30 ft., From ft. to ft.  
From ft. to ft., From ft. to ft.

6 GROUT MATERIAL: 3 1 Neat cement 2 Cement grout 3 Bentonite 4 Other  
Grout Intervals: From 0 ft. to 8 ft., From ft. to ft., From ft. to ft.  
What is the nearest source of possible contamination: None 10 Livestock pens 14 Abandoned water well  
1 Septic tank 4 Lateral lines 7 Pit privy 11 Fuel storage 15 Oil well/Gas well  
2 Sewer lines 5 Cess pool 8 Sewage lagoon 12 Fertilizer storage 16 Other (specify below)  
3 Watertight sewer lines 6 Seepage pit 9 Feedyard 13 Insecticide storage *None*

Direction from well? How many feet?

FROM	TO	LITHOLOGIC LOG	FROM	TO	PLUGGING INTERVALS
0	2	Topsoil			
2	4	Gumbo			
4	9	Soft clay			
9	10	Clay and very little sand			
10	26	Soft clay			
26	27	Rock			
27	30	Soft clay			

7 CONTRACTOR'S OR LANDOWNER'S CERTIFICATION: This water well was (1) constructed, (2) reconstructed, or (3) plugged under my jurisdiction and was completed on (mo/day/year) 4/4/94 and this record is true to the best of my knowledge and belief. Kansas Water Well Contractor's License No. 199 This Water Well Record was completed on (mo/day/yr) 4/27/94 under the business name of Karst Water Well Crilling & Service, Inc. by signature *[Signature]*