


1 LOCATION OF WATER WELL: County: Russell Fraction: SE 1/4 NE 1/4 NW 1/4 Section Number: 27 Township Number: T 13 S Range Number: R 14 EW

Distance and direction from nearest town or city street address of well if located within city? RUSSELL 1203 Brooks

2 WATER WELL OWNER: WAYNE MARIETTA RR#, St. Address, Box #: 1203 Brooks City, State, ZIP Code: RUSSELL, Kansas 67665 Board of Agriculture, Division of Water Resources Application Number:

3 LOCATE WELL'S LOCATION WITH AN "X" IN SECTION BOX:

4 DEPTH OF COMPLETED WELL: 20 ft. ELEVATION:

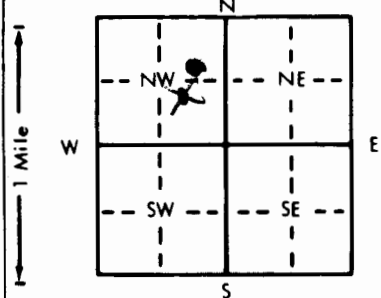

Depth(s) Groundwater Encountered: 1 17 ft. 2. WELL'S STATIC WATER LEVEL: 14 ft. below land surface measured on mo/day/yr 11/4/89 Pump test data: Well water was 14 ft. after 3 hours pumping gpm Est. Yield gpm: Well water was Bore Hole Diameter: WELL WATER TO BE USED AS: 5 Public water supply 8 Air conditioning 11 Injection well 1 Domestic 3 Feedlot 6 Oil field water supply 9 Dewatering 12 Other (Specify below) 2 Irrigation 4 Industrial 7 Lawn and garden only 10 Monitoring well Was a chemical/bacteriological sample submitted to Department? Yes No X If yes, mo/day/yr sample was submitted Water Well Disinfected? Yes No

5 TYPE OF BLANK CASING USED: 1 Steel 3 RMP (SR) 5 Wrought iron 8 Concrete tile CASING JOINTS: Glued Clamped 2 PVC 4 ABS 6 Asbestos-Cement 9 Other (specify below) Welded Threaded.

Blank casing diameter: 4 in. to Dia. in. to lbs./ft. Wall thickness or gauge No. Casing height above land surface: 12 in., weight

TYPE OF SCREEN OR PERFORATION MATERIAL: 1 Steel 3 Stainless steel 5 Fiberglass 8 RMP (SR) 10 Asbestos-cement 2 Brass 4 Galvanized steel 6 Concrete tile 9 ABS 11 Other (specify) 12 None used (open hole)

SCREEN OR PERFORATION OPENINGS ARE: 1 Continuous slot 3 Mill slot 5 Gauzed wrapped 8 Saw cut 11 None (open hole) 2 Louvered shutter 4 Key punched 6 Wire wrapped 9 Drilled holes 10 Other (specify) 7 Torch cut 20

SCREEN-PERFORATED INTERVALS: From 14 ft. to 20 ft. GRAVEL PACK INTERVALS:

6 GROUT MATERIAL: 1 Neat cement 2 Cement grout 3 Bentonite 4 Other Grout Intervals: From 3 ft. to 10 ft.

What is the nearest source of possible contamination: 1 Septic tank 4 Lateral lines 7 Pit privy 10 Livestock pens 14 Abandoned water well 2 Sewer lines 5 Cess pool 8 Sewage lagoon 11 Fuel storage 15 Oil well/Gas well 3 Watertight sewer lines 6 Seepage pit 9 Feedyard 12 Fertilizer storage 16 Other (specify below) 13 Insecticide storage

Direction from well? How many feet?

Table with columns: FROM, TO, LITHOLOGIC LOG, FROM, TO, PLUGGING INTERVALS. Data: 0-5 Topsoil, 5-10 Clay, 10-15 rock, 15-20 coarse sand.

7 CONTRACTOR'S OR LANDOWNER'S CERTIFICATION: This water well was (1) constructed (2) reconstructed, or (3) plugged under my jurisdiction and was completed on (mo/day/year) 11/4/89 and this record is true to the best of my knowledge and belief. Kansas Water Well Contractor's License No. 521 This Water Well Record was completed on (mo/day/yr) 11/9/89 under the business name of FROELICH'S DRILLING SERVICE by (signature) Jonathan Froelich