


1 LOCATION OF WATER WELL: County: RUSSELL Fraction: JW 1/4 NE 1/4 NW 1/4 Section Number: 27 Township Number: T 13 S Range Number: R 14 W

Distance and direction from nearest town or city street address of well if located within city?
385 W 12 RUSSELL, KS

2 WATER WELL OWNER: BILL BURTON
 RR#, St. Address, Box #: 385 W 12
 City, State, ZIP Code: RUSSELL, KS 67665
 Board of Agriculture, Division of Water Resources
 Application Number:

3 LOCATE WELL'S LOCATION WITH AN "X" IN SECTION BOX:

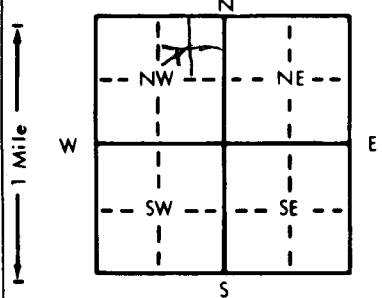

4 DEPTH OF COMPLETED WELL: 26 ft. ELEVATION:
 Depth(s) Groundwater Encountered: 13 ft. 2. 20 ft. 3.
 WELL'S STATIC WATER LEVEL: 13 ft. below land surface measured on mo/day/yr 5/19/91
 Pump test data: Well water was 13 ft. after 4 hours pumping 5 gpm
 Est. Yield: Well water was 13 ft. after 4 hours pumping 5 gpm
 Bore Hole Diameter: 7 in. to 26 ft., and 26 in. to 26 ft.
 WELL WATER TO BE USED AS:
 5 Public water supply 8 Air conditioning 11 Injection well
 1 Domestic 3 Feedlot 6 Oil field water supply 9 Dewatering 12 Other (Specify below)
 2 Irrigation 4 Industrial 7 Lawn and garden only 10 Monitoring well
 Was a chemical/bacteriological sample submitted to Department? Yes Yes No No If yes, mo/day/yr sample was submitted
 Water Well Disinfected? Yes No

5 TYPE OF BLANK CASING USED:
 1 Steel 3 RMP (SR) 5 Wrought iron 8 Concrete tile CASING JOINTS: Glued X Clamped
2 PVC 4 ABS 7 Fiberglass Welded
 Blank casing diameter: 4 in. to 26 ft. Dia. in. to 26 ft. Dia. in. to 26 ft.
 Casing height above land surface: 12 in., weight 12 lbs./ft. Wall thickness or gauge No.

TYPE OF SCREEN OR PERFORATION MATERIAL:
 1 Steel 3 Stainless steel 5 Fiberglass 8 RMP (SR) 10 Asbestos-cement
 2 Brass 4 Galvanized steel 6 Concrete tile 9 ABS 11 Other (specify)
 12 None used (open hole)

SCREEN OR PERFORATION OPENINGS ARE:
 1 Continuous slot 3 Mill slot 5 Gauzed wrapped 8 Saw cut 11 None (open hole)
 2 Louvered shutter 4 Key punched 6 Wire wrapped 9 Drilled holes
 7 Torch cut 26 10 Other (specify)

SCREEN-PERFORATED INTERVALS: From 13 ft. to 26 ft. From 10 ft. to 26 ft.
 GRAVEL PACK INTERVALS: From 10 ft. to 26 ft. From 10 ft. to 26 ft.

6 GROUT MATERIAL: 1 Neat cement 2 Cement grout 3 Bentonite 4 Other
 Grout Intervals: From 0 ft. to 10 ft. From 10 ft. to 26 ft.

What is the nearest source of possible contamination:
 1 Septic tank 4 Lateral lines 7 Pit privy 10 Livestock pens 14 Abandoned water well
 2 Sewer lines 5 Cess pool 8 Sewage lagoon 11 Fuel storage 15 Oil well/Gas well
 3 Watertight sewer lines 6 Seepage pit 9 Feedyard 12 Fertilizer storage 16 Other (specify below)
 13 Insecticide storage

Direction from well? West How many feet? 700

FROM	TO	LITHOLOGIC LOG	FROM	TO	PLUGGING INTERVALS
0	15	clay			
15	20	water			
20	25	water and sand			
25	26	rock			

7 CONTRACTOR'S OR LANDOWNER'S CERTIFICATION: This water well was (1) constructed, (2) reconstructed, or (3) plugged under my jurisdiction and was completed on (mo/day/year) 5/20/91 and this record is true to the best of my knowledge and belief. Kansas Water Well Contractor's License No. 521 This Water Well Record was completed on (mo/day/yr) 5/20/91 under the business name of Joe Wollich's Water Well Serv (signature) Jon Froelich