


1 LOCATION OF WATER WELL: County: RUSSELL Fraction: SE 1/4 SE 1/4 NE 1/4 Section Number: 27 Township Number: T 13 S Range Number: R 14 EW  
 Distance and direction from nearest town or city street address of well if located within city? 133 W. 8TH S-1

2 WATER WELL OWNER: CITY OF RUSSELL RR#, St. Address, Box #: 133 WEST 8TH Board of Agriculture, Division of Water Resources  
 City, State, ZIP Code: RUSSELL, KS 67665 Application Number:

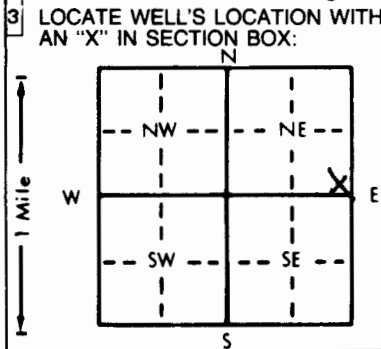

4 DEPTH OF COMPLETED WELL: 18 ft. ELEVATION:  
 Depth(s) Groundwater Encountered 1. 15 ft. 2. 18 ft. 3. 18 ft.  
 WELL'S STATIC WATER LEVEL: 15 ft. below land surface measured on mo/day/yr  
 Pump test data: Well water was \_\_\_\_\_ ft. after \_\_\_\_\_ hours pumping \_\_\_\_\_ gpm  
 Est. Yield \_\_\_\_\_ gpm Well water was \_\_\_\_\_ ft. after \_\_\_\_\_ hours pumping \_\_\_\_\_ gpm  
 Bore Hole Diameter: 8 in. to 18 in. to \_\_\_\_\_ in. to \_\_\_\_\_ in. to \_\_\_\_\_ ft.  
 WELL WATER TO BE USED AS:  
 5 Public water supply 8 Air conditioning 11 Injection well  
 1 Domestic 3 Feedlot 6 Oil field water supply 9 Dewatering 12 Other (Specify below)  
 2 Irrigation 4 Industrial 7 Lawn and garden only 10 Monitoring well  
 Was a chemical/bacteriological sample submitted to Department? Yes \_\_\_\_\_ No ✓; If yes, mo/day/yr sample was sub-  
 mitted Water Well Disinfected? Yes \_\_\_\_\_ No ✓

5 TYPE OF BLANK CASING USED:  
 1 Steel 3 RMP (SR) 5 Wrought iron 8 Concrete tile CASING JOINTS: Glued \_\_\_\_\_ Clamped \_\_\_\_\_  
2 PVC 4 ABS 6 Asbestos-Cement 9 Other (specify below) Welded \_\_\_\_\_  
 7 Fiberglass Threaded ✓  
 Blank casing diameter: 2 in. to 8 in. Dia \_\_\_\_\_ in. to \_\_\_\_\_ in. to \_\_\_\_\_ in. to \_\_\_\_\_ in. to \_\_\_\_\_ ft.  
 Casing height above land surface \_\_\_\_\_ in., weight \_\_\_\_\_ lbs./ft. Wall thickness or gauge No. \_\_\_\_\_  
 TYPE OF SCREEN OR PERFORATION MATERIAL:  
 1 Steel 3 Stainless steel 5 Fiberglass 7 PVC 10 Asbestos-cement  
 2 Brass 4 Galvanized steel 6 Concrete tile 8 RMP (SR) 11 Other (specify) \_\_\_\_\_  
 12 None used (open hole)  
 SCREEN OR PERFORATION OPENINGS ARE:  
 1 Continuous slot 3 Mill slot 5 Gauzed wrapped 8 Saw cut 11 None (open hole)  
 2 Louvered shutter 4 Key punched 6 Wire wrapped 9 Drilled holes  
 7 Torch cut 10 Other (specify) \_\_\_\_\_  
 SCREEN-PERFORATED INTERVALS: From 8 ft. to 18 ft. From \_\_\_\_\_ ft. to \_\_\_\_\_ ft.  
 From \_\_\_\_\_ ft. to \_\_\_\_\_ ft. From \_\_\_\_\_ ft. to \_\_\_\_\_ ft.  
 GRAVEL PACK INTERVALS: From 7 ft. to 18 ft. From \_\_\_\_\_ ft. to \_\_\_\_\_ ft.  
 From \_\_\_\_\_ ft. to \_\_\_\_\_ ft. From \_\_\_\_\_ ft. to \_\_\_\_\_ ft.

6 GROUT MATERIAL: 1 Neat cement 2 Cement grout 3 Bentonite 4 Other \_\_\_\_\_  
 Grout intervals: From 0 ft. to 7 ft., From \_\_\_\_\_ ft. to \_\_\_\_\_ ft., From \_\_\_\_\_ ft. to \_\_\_\_\_ ft.  
 What is the nearest source of possible contamination:  
 1 Septic tank 4 Lateral lines 7 Pit privy 10 Livestock pens 14 Abandoned water well  
 2 Sewer lines 5 Cess pool 8 Sewage lagoon 11 Fuel storage 15 Oil well/Gas well  
 3 Watertight sewer lines 6 Seepage pit 9 Feedyard 12 Fertilizer storage 16 Other (specify below)  
 13 Insecticide storage  
 Direction from well? WITHIN SITE How many feet? WITHIN

| FROM | TO | LITHOLOGIC LOG                 | FROM | TO | PLUGGING INTERVALS |
|------|----|--------------------------------|------|----|--------------------|
| 0    | 12 | SILTY SANDY CLAY               |      |    |                    |
| 12   | TD | SAND + GRAVEL<br>w/CLAY LAYERS |      |    |                    |
|      |    |                                |      |    |                    |
|      |    |                                |      |    |                    |
7 CONTRACTOR'S OR LANDOWNER'S CERTIFICATION: This water well was (1) constructed, (2) reconstructed, or (3) plugged under my jurisdiction and was completed on (mo/day/year) 9/19/92 and this record is true to the best of my knowledge and belief. Kansas Water Well Contractor's License No. 102 This Water Well Record was completed on (mo/day/yr) 9/21/92 under the business name of LAYNE WESTERN CO. WICHITA by (signature) [Signature]