


WATER WELL RECORD Form WWC-5 KSA 82a-1212

1 LOCATION OF WATER WELL: County: **Russell** Fraction: **NW 1/4 NE 1/4 NE 1/4** Section Number: **34** Township Number: **T 13 S** Range Number: **R 14 W**  
 Distance and direction from nearest town or city street address of well if located within city?  
**25 S. Main**

2 WATER WELL OWNER: **Leroys Conoco**  
 RR#, St. Address, Box #: **25 S. Main**  
 City, State, ZIP Code: **Russell, Kansas 67665**  
 Board of Agriculture, Division of Water Resources  
 Application Number: **1842.5**

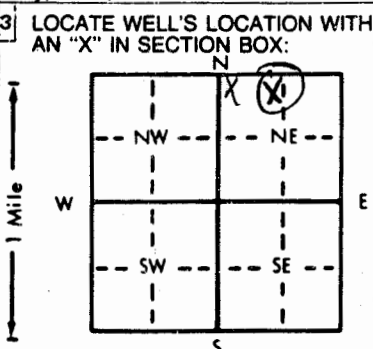

4 DEPTH OF COMPLETED WELL: **15** ft. ELEVATION: ..... ft.  
 Depth(s) Groundwater Encountered: 1. **13.7** ft. 2. .... ft. 3. **1/10/95** ft.  
 WELL'S STATIC WATER LEVEL: ..... ft. below land surface measured on mo/day/yr  
 Pump test data: Well water was ..... ft. after ..... hours pumping ..... gpm  
 Est. Yield: **NA** gpm: Well water was **15** ft. after ..... hours pumping ..... gpm  
 Bore Hole Diameter: ..... in. to ..... ft., and ..... in. to ..... ft.  
 WELL WATER TO BE USED AS:  
 5 Public water supply 8 Air conditioning 11 Injection well  
 1 Domestic 3 Feedlot 6 Oil field water supply 9 Dewatering 12 Other (Specify below)  
 2 Irrigation 4 Industrial 7 Lawn and garden only **10 Monitoring well**  
 Was a chemical/bacteriological sample submitted to Department? Yes.....No.....; If yes, mo/day/yr sample was submitted  
 Water Well Disinfected? Yes No

5 TYPE OF BLANK CASING USED:  
 1 **Steel** 3 RMP (SR) 5 Wrought iron 8 Concrete tile CASING JOINTS: Glued ..... Clamped .....  
 2 **PVC** 4 ABS 6 Asbestos-Cement 9 Other (specify below) Welded ..... **X** .....  
 Blank casing diameter: **2** in. to ..... ft., Dia ..... in. to ..... ft., Dia ..... in. to ..... ft.  
 Casing height above land surface: **-2** in., weight ..... lbs./ft. Wall thickness or gauge No. **Sch. 40**  
 TYPE OF SCREEN OR PERFORATION MATERIAL:  
 1 Steel 3 Stainless steel 5 Fiberglass 8 RMP (SR) 10 Asbestos-cement  
 2 Brass 4 Galvanized steel 6 Concrete tile 9 ABS 11 Other (specify) .....  
 12 None used (open hole)  
 SCREEN OR PERFORATION OPENINGS ARE:  
 1 Continuous slot 3 **Mill slot** 5 Gauzed wrapped 8 Saw cut 11 None (open hole)  
 2 Louvered shutter 4 Key punched 6 Wire wrapped 9 Drilled holes  
 7 Torch cut 10 Other (specify) .....  
 SCREEN-PERFORATED INTERVALS: From **5** ft. to **15** ft., From ..... ft. to ..... ft.  
 From ..... ft. to ..... ft., From ..... ft. to ..... ft.  
 GRAVEL PACK INTERVALS: From **4** ft. to **15** ft., From ..... ft. to ..... ft.  
 From ..... ft. to ..... ft., From ..... ft. to ..... ft.

6 GROUT MATERIAL:  
 1 Neat cement 2 **Cement grout** 3 **Bentonite** 4 Other .....  
 Grout Intervals: From **0** ft. to **3** ft., From **3** ft. to **4** ft., From ..... ft. to ..... ft.  
 What is the nearest source of possible contamination:  
 1 Septic tank 4 Lateral lines 7 Pit privy 10 Livestock pens 14 Abandoned water well  
 2 Sewer lines 5 Cess pool 8 Sewage lagoon 11 Fuel storage 15 Oil well/Gas well  
 3 Watertight sewer lines 6 Seepage pit 9 Feedyard 12 Fertilizer storage 13 Insecticide storage  
 13 **Other (specify below)**  
 UST  
 Direction from well? **NNW** How many feet? **130**

| FROM | TO | LITHOLOGIC LOG                           | FROM | TO | PLUGGING INTERVALS             |
|------|----|--|------|----|--------------------------------|
| 0    | 4  | Clay, Dark Brown                         |      |    | MW9                            |
| 2.5  | 6  | Clay, Light Brown                        |      |    | GeoCore # 59 Flush-mount Cover |
| 6    | 12 | Clay, Very Light Brown Mottled with Yell |      |    | KDHE # 06084683B Tag # 114404  |
| 12   | 15 | Clay, Moderate Yellow to Brown           |      |    |                                |
| 0    | 4  | Asphalt,                                 |      |    |                                |

7 CONTRACTOR'S OR LANDOWNER'S CERTIFICATION: This water well was **1** constructed, **2** reconstructed, or **3** plugged under my jurisdiction and was completed on (mo/day/year) **1/18/95** and this record is true to the best of my knowledge and belief. Kansas Water Well Contractor's License No. **527** This Water Well Record was completed on (mo/day/yr) **2/13/95** under the business name of **GeoCore Services, Inc.** by (signature) *Paul Holt*