


1	LOCATION OF WATER WELL:	Fraction	Section Number	Township Number	Range Number
	County: <u>RUSSELL</u>	<u>SW 1/4 SE 1/4 SE 1/4</u>	<u>14</u>	<u>13</u>	<u>15W</u>

Distance and direction from nearest town or city street address of well if located within city?

2 WATER WELL OWNER: BIG CREEK TWP
 RR#, St. Address, Box #: 40 SANDY BLUNDON Board of Agriculture, Division of Water Resources
 City, State, ZIP Code: 17953 FAIRFIELD RD. RUSSELL, KS 67665 Application Number:

3 MARK WELL'S LOCATION WITH AN "X" IN SECTION BOX:

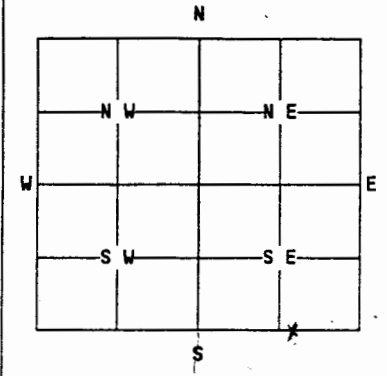

4 DEPTH OF WELL.....12.....ft.

WELL'S STATIC WATER LEVEL....8.....ft.

WELL WAS USED AS:

- 1 Domestic
- 2 Irrigation
- 3 Feedlot
- 4 Industrial
- 5 Public Water Supply
- 6 Oil Field Water Supply
- 7 Lawn and Garden Only
- 8 Air Conditioning
- 9 Dewatering
- 10 Monitoring Well
- 11 Injection Well
- 12 Other...N.P.T. SURE

Was a chemical/bacteriological sample submitted to Department? Yes....No...X
 If yes, mo/day/yr sample was submitted.....

Water Well Disinfected: Yes...X... No.....

5 TYPE OF BLANK CASING USED:

- 1 Steel
- 2 PVC
- 3 RMP (SR)
- 4 ABS
- 5 Wrought
- 6 Asbestos-Cement
- 7 Fiberglass
- 8 Concrete Tile
- 9 Other (specify below) LIME STONE ROCK

Blank casing diameter...3 FT... Was casing pulled? Yes..... No...X.. If yes, how much.....
 Casing height above or below land surface...2 FT.....in.

6 GROUT PLUG MATERIAL: 1 Neat cement 2 Cement grout 3 Bentonite 4 Other.....
6 BAGS

Grout Plug Intervals: From...5...ft. to...3...ft., From.....ft. toft., From..... to.....ft.

What is the nearest source of possible contamination:

- 1 Septic tank
- 2 Sewer lines
- 3 Watertight sewer lines
- 4 Lateral lines
- 5 Cess Pool
- 6 Seepage pit
- 7 Pit privy
- 8 Sewage lagoon
- 9 Feedyard
- 10 Livestock pens
- 11 Fuel storage
- 12 Fertilizer storage
- 13 Insecticide storage
- 14 Abandoned water well
- 15 Oil well/Gas well
- 16 Other (specify below)

Direction from well? Southeast..... How many feet? ...150.....

FROM	TO	PLUGGING MATERIALS
<u>12</u>	<u>8</u>	<u>SAND (28.3 Cubic ft)</u>
<u>8</u>	<u>5</u>	<u>CLAYS (21.2 cubic ft)</u>
<u>5</u>	<u>4</u>	<u>Bentonite (6 Bags 90 LBS)</u>
<u>4</u>	<u>0</u>	<u>CLAYS</u>

7 CONTRACTOR'S OR LANDOWNER'S CERTIFICATION: This water well was plugged under my jurisdiction and was completed on (mo/day/year) 2-25-97 and this record is true to the best of my knowledge and belief. Kansas Water Well Contractor's License No. 003 This Water Well Record was completed on (mo/day/year) 2-25-97 under the business name of BIG CREEK TWP by (signature) [Signature] (Clerk)

INSTRUCTIONS: Use typewriter or ball point pen. Please press firmly and print clearly. Please fill in blanks, underline or circle the correct answers. Send top three copies to Kansas Department of Health and Environment, Bureau of Water, Topeka, Kansas 66620-0001. Telephone: 913/296-3565. Send one to Water Well Owner and retain one for your records.