


1 LOCATION OF WATER WELL:	Fraction NC	Section Number 31	Township Number 13	Range Number 15 W E/W
County: Russell	$\frac{1}{4}$ $\frac{1}{4}$ $\frac{1}{4}$			

Distance and direction from nearest town or city street address of well if located within city?
West edge of Gorham 150' south of old 40 Hwy

2 WATER WELL OWNER: City of Gorham	Board of Agriculture, Division of Water Resources
RR #, St. Address, Box #: PO Box 25	Application Number:
City, State, ZIP Code: Gorham Ks 67640	

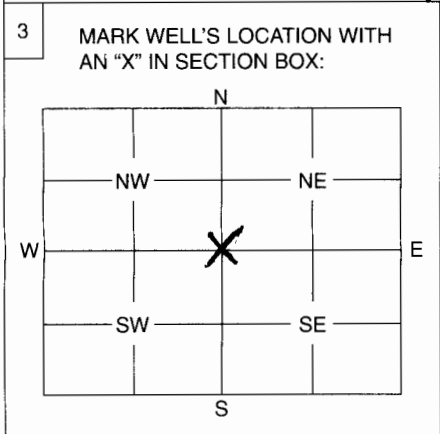

4 DEPTH OF WELL 46 ft.
WELL'S STATIC WATER LEVEL 6 ft.
WELL WAS USED AS:
<input checked="" type="radio"/> Domestic <input type="radio"/> Irrigation <input type="radio"/> Feedlot <input type="radio"/> Industrial
<input type="radio"/> Public Water Supply <input type="radio"/> Oil Field Water Supply <input type="radio"/> Domestic (Lawn & Garden) <input type="radio"/> Air Conditioning
<input type="radio"/> Dewatering <input type="radio"/> Monitoring Well <input type="radio"/> Injection Well <input type="radio"/> Other
Was a chemical / bacteriological sample submitted to Department? Yes No <input checked="" type="checkbox"/>
If yes, mo/day/yr sample was submitted
Water Well Disinfected: Yes <input checked="" type="checkbox"/> No

5 TYPE OF BLANK CASING USED:	1 Steel 3 RMP (SR) 5 Wrought 7 Fiberglass <input checked="" type="radio"/> Other (Specify below) 2 PVC 4 ABS 6 Asbestos-Cement 8 Concrete Tile Steel & Cement
Blank casing diameter 10 in.	Was casing pulled? Yes No <input checked="" type="checkbox"/> If yes, how much
Casing height above or below land surface Level in.	

6 GROUT PLUG MATERIAL: <input checked="" type="radio"/> Neat cement	2 Cement grout 3 Bentonite 4 Other
Grout Plug Intervals: From 4 ft. to 0 ft.,	From ft. to ft., From to ft.
What is the nearest source of possible contamination:	
1 Septic tank 2 Sewer lines 3 Watertight sewer lines 4 Lateral lines 5 Cess pool	6 Seepage pit 7 Pit privy 8 Sewage lagoon 9 Feedyard 10 Livestock pens
	11 Fuel storage 12 Fertilizer storage 13 Insecticide storage 14 Abandoned water well 15 Oil well/Gas well 16 Other (specify below)
Direction from well?	How many feet?

FROM	TO	PLUGGING MATERIALS
46'	4'	Sand
4'	0'	Cement

7 CONTRACTOR'S OF LANDOWNER'S CERTIFICATION:	This water well was plugged under my jurisdiction and was completed on (mo/day/year) 2-24-2008 and this record is true to the best of my knowledge and belief. Kansas Water Well Contractor's License No. This Water Well Record was completed on (mo/day/year) under the business name of by (signature) Douglas W. Sherata
--	---

INSTRUCTIONS: Use typewriter or ball point pen. Please press firmly and print clearly. Please fill in blanks, underline or circle the correct answers. Send top three copies to Kansas Department of Health and Environment, Bureau of Water, Geology Section, 1000 SW Jackson St., Ste. 420, Topeka, Kansas 66612-1367. Telephone: 785/296-5522. Send one to Water Well Owner and retain one for your records.